


STATE ENGINEER
Salem, Oregon

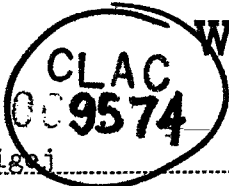

Well Record

STATE WELL NO. 3/1-23D(1)
COUNTY Clackamas
APPLICATION NO. GR-731

OWNER: Fred W. Bigaj


MAILING ADDRESS: Route 1, Box 40

LOCATION OF WELL: Owner's No. #1

CITY AND STATE: Oregon City, Oregon

N
NW 1/4 NW 1/4 Sec. 23 T. 3 S., R. 1 W., W.M.

Bearing and distance from section or subdivision
corner 1200' E. & 150' S. from NW corner of
Section 23.

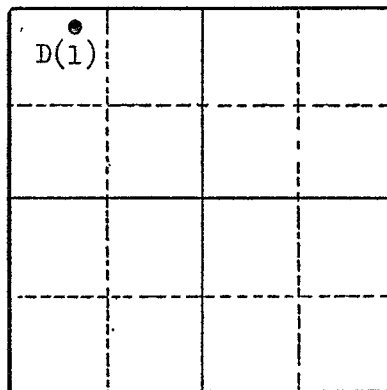

Section 23

Altitude at well 220' Interpolated

TYPE OF WELL: Drilled Date Constructed 1952

Depth drilled 220' Depth cased 24'

CASING RECORD:

6-inch from 0 to 24'

FINISH:

8" hole drilled into rock and pipe cemented at 24' level

AQUIFERS:

Water from 220' crevice

WATER LEVEL:

123'

PUMPING EQUIPMENT: Type Three phase electric - Sumo submersible H.P. 5
Capacity 80 G.P.M.

WELL TESTS:

Drawdown 28 ft. after 180 hours 5 G.P.M.

Drawdown 5 1/2 ft. after 50 hours 5 G.P.M.

USE OF WATER Irrigation Temp. °F. 19

SOURCE OF INFORMATION GR-731

DRILLER or DIGGER

ADDITIONAL DATA:

Log x Water Level Measurements Chemical Analysis Aquifer Test

REMARKS:

