

STATE ENGINEER
Salem, Oregon

CLAC
00963

Well Record

STATE WELL NO. 1/4E-28K
COUNTY Clackamas
APPLICATION NO. CR-3572

OWNER: Stockton Paulson


MAILING ADDRESS: Route 1, Box 347

LOCATION OF WELL: Owner's No. _____

CITY AND STATE: Boring, Oregon

NW 1/4 SE 1/4 Sec. 28 T. 1 S., R. 4 W., W.M.

Bearing and distance from section or subdivision corner S. 61° 00' W. from E 1/4 corner Sec. 28

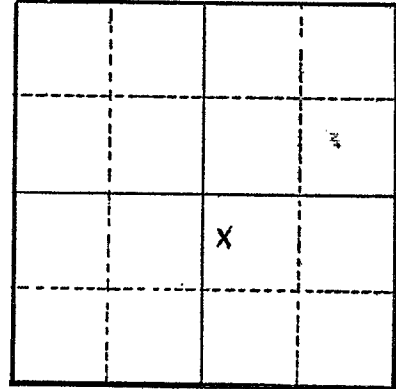

Section 28

Altitude at well _____

TYPE OF WELL: Drilled Date Constructed June, 1952

Depth drilled 280 ft. Depth cased 280 ft.

CASING RECORD:

10 inch steel casing set to 280 feet

FINISH:

perforated

AQUIFERS:

WATER LEVEL:

PUMPING EQUIPMENT: Type Universal Gasoline H.P. 30
Capacity 200 G.P.M.

WELL TESTS:

Drawdown _____ ft. after _____ hours _____ G.P.M.

Drawdown _____ ft. after _____ hours _____ G.P.M.

USE OF WATER Irrigation Temp. _____ °F., 19 _____

SOURCE OF INFORMATION Well Registration Statement

DRILLER or DIGGER O. B. Olsen

ADDITIONAL DATA:

Log _____ Water Level Measurements _____ Chemical Analysis _____ Aquifer Test _____

REMARKS: