

STATE ENGINEER
Salem, Oregon

CLAC
9648

OBSERVATION WELL
Well Record

STATE WELL NO. 3/1-26E(1)
COUNTY Clackamas
APPLICATION NO. GR-624

OWNER: Amil R. & Helen G. Slaby


MAILING ADDRESS: Route 1, Box 538

LOCATION OF WELL: Owner's No. 1

CITY AND STATE: Canby, Oregon

SW 1/4 NW 1/4 Sec. 26 T. 3 N. S. R. 1 W. W.M.

Bearing and distance from section or subdivision
corner 1180' N. of SW corner of Joseph Parrott
DLC along W. boundary of said DLC thence
E. 1277'

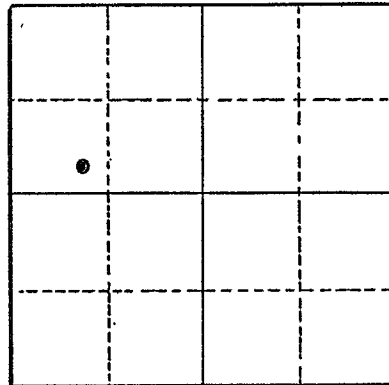

Section 26

Altitude at well 190' Interpolated

TYPE OF WELL: Drilled Date Constructed 4/10/55

Depth drilled 230 Depth cased 173

CASING RECORD:

6-inch

FINISH:

AQUIFERS:

WATER LEVEL:

99'

PUMPING EQUIPMENT: Type Sumo submersible H.P. 47
Capacity 52 G.P.M.

WELL TESTS:

Drawdown 37 ft. after 5 1/2 hours 76 G.P.M.
Drawdown ft. after hours G.P.M.

USE OF WATER Irrigation 11 acres Temp. °F., 19

SOURCE OF INFORMATION GR-624

DRILLER or DIGGER

ADDITIONAL DATA:

Log Water Level Measurements Chemical Analysis Aquifer Test

REMARKS:

