
The original and first copy of this report are to be filed with the STATE OF OREGON

STATE ENGINEER, SALEM, OREGON 97210 ENGINEER type or print) within 30 days from the date! ATE ENGINEER type or print) of well completion. SALEM. OF: (100 hot write above this line)

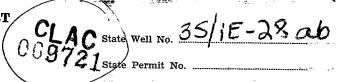

Address Rt. 3 Box 421, Canby, Ore, 97013	Name Lee M. Rhoads					
CASING INSTALLED: Threaded   Wolded E   S   Diam. from	Durg D Poned D Tenteration of the Control of					
PERFORATIONS:  Perforated?   Yes   No.  Type of perforator used  Size of perforations from	8 "Diam from 0 ft. to 94 ft. Gage .250	(12) WELL LOG: Diameter of well below casing 8tt.  Depth drilled 140 ft. Depth of completed well 127 ft.  Formation: Describe color, texture, grain size and structure of materials.				
Size of perforations   In. by   in.	DEPENDATIONS.	and show thickness and nature of each stratum and aquifer penetrated, with at least one entry for each change of formation. Report each change in				
Size of perforations from	<del>_</del>		1			
Cravel_Boulders-Cemented						
Gravel-Nater   110   127   77						
Manufacturer's Name  Type  Model No.  Diam. Slot size Set from ft. to ft.  Slot size Set from ft. to ft.  (8) WELL TESTS: Drawdown is amount water level is lowered below static level  Was a pump test made? Pyes No if yes, by whom? Priller  Yield: 50 gal/min. with ft. drawdown after x hrs.  """""""""""""""""""""""""""""""""""					77	
Manufacturer's Name    Model No.   Diam.   Slot size   Set from   ft. to   ft.	Wen bereen mistaned. I les Killo					
Diam. Slot size Set from ft. to ft. Diam. Slot size Set from ft. Slot size Set Set from ft. Slot size						
Slot size						
West a pump test made?  Ses No if yes, by whom? Driller  Was a pump test made?  Ses No if yes, by whom? Driller  Yield:  So gal/min. with 6 ft. drawdown after 7 hrs.  """"  "Baller test gal/min. with 1ft. drawdown after hrs.  Artesian flow Ep.m.  Depth artesian flow encountered ft.  Work started 6-27 1972 Completed 6-28 1972  Date well drilling machine moved off of well 6-28 1972  Date well drilling machine moved off of well 6-28 1972  Date well drilling machine operator's Certification:  This well was constructed under my direct supervision. Materials used and information reported above are true to my best knowledge, and profit.  Sacks  Number of sacks of cement used in well seal sacks  Number of sacks of bentonite per 100 gallons  of water National National  Was a drive shoe used?  Yes No Plugs Size: location ft.  Did any strata contain unusable water?  Yes E No Plugs Size: location ft.  Did any strata contain unusable water?  Yes E No size of gravel:  Was well gravel packed? Yes E No size of gravel:  Gravel placed from ft. to ft.  Contractor's License No. 497 Date 7-16, 1972  Contractor's License No. 497 Date 7-16, 1972						




Was a drive shoe used?	·	·				
Did any strata contain unusable water?	•	true to the best of my knowledge and belief.				
Method of sealing strata off Address Rt. 1 Rox 31, Canby, Ore. 97013   Was well gravel packed? □ Yes ☑ No Size of gravel: [Signed] (Water Well Contractor)   Gravel placed from	· · ·					
Method of sealing strata off  Was well gravel packed? ☐ Yes ☑ No Size of gravel:  Gravel placed fromft. toft. Contractor's License No	The state of the s					
Was well gravel packed?  Yes No Size of gravel:    [Signed]		Address	Ore.	9701	.3	
Was well gravel packed?   Yes   No   Size of gravel: (Water Well Contractor)  Gravel placed fromft. toft.   Contractor's License No497. Date7=16		[Signed] / Jallu Maci				
19.72 Date		(Water Well Contrac	ctor)			
		Contractor's License No. 497 Date	7-16	,	19.7.2	