

STATE ENGINEER
Salem, Oregon

CLAC
9746

Well Record


STATE WELL NO. 3/1-28F
COUNTY Clackamas
APPLICATION NO. GR-4273

OWNER: Aldrich O. and Marjorie A. Soyring Mailing ADDRESS: Route 3, Box 392 A

LOCATION OF WELL: Owner's No. CITY AND STATE: Oregon

SE 1/4 NW 1/4 Sec. 28 T. 3 N. S., R. 1 W., W.M.

Bearing and distance from section or subdivision
corner 122 feet North and 77 feet East of the SW
Corner, Lot 22

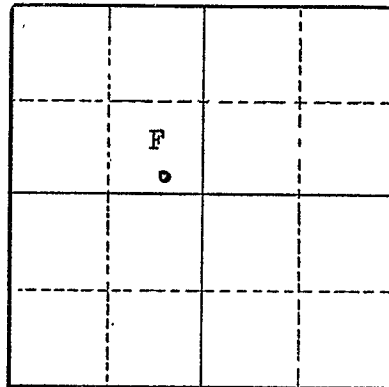

Section 28

Altitude at well 100 feet

TYPE OF WELL: Drilled Date Constructed Feb. 21, 1951

Depth drilled 97 feet Depth cased 97 feet

CASING RECORD:

8-inch steel casing from 0 to 97 feet

FINISH:

30 slots at bottom of casing
no screening

AQUIFERS:

sand and gravel

WATER LEVEL:

65 feet

PUMPING EQUIPMENT: Type Pacific Power and Pump H.P.
Capacity 65 G.P.M.

WELL TESTS:

Drawdown 1-2 ft. after 120 hours G.P.M.
Drawdown ft. after hours G.P.M.

USE OF WATER Irrigation Temp. °F., 19

SOURCE OF INFORMATION GR-4125

DRILLER or DIGGER G. L. Zeising, Portland, Oregon

ADDITIONAL DATA:

Log Water Level Measurements Chemical Analysis Aquifer Test

REMARKS:

sand 65 to 67 feet
several feet of gravel