

STATE ENGINEER  
Salem, Oregon



# Well Record

STATE WELL NO. 3/1-28G  
COUNTY CLACKAMAS  
APPLICATION NO. GR-2565

OWNER: Ralph P. Sticka


MAILING ADDRESS: Rt. 3, Box 425

LOCATION OF WELL: Owner's No.

CITY AND STATE: Canby, Oregon

SW 1/4 NE 1/4 Sec. 28 T. 3 N. S., R. 1 E. W.M.

Bearing and distance from section or subdivision corner 1850' S. & 200' E!

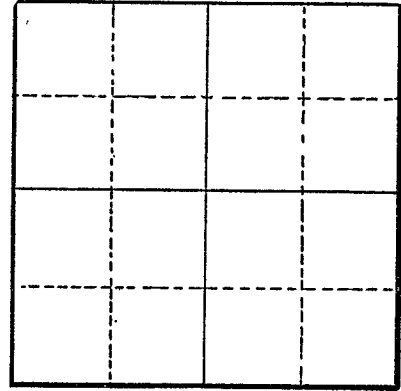

Section

Altitude at well

TYPE OF WELL: Drilled Date Constructed 1941

Depth drilled 80 Depth cased 84

### CASING RECORD:

6-inch

### FINISH:

5 per foot per row 3 rows 3/8 x 1 1/2 slots from 64 to 80

### AQUIFERS:

Topsoil, gravel, sand and boulders

### WATER LEVEL:

48-feet

PUMPING EQUIPMENT: Type Peerless Turbine H.P. 5  
Capacity 100 G.P.M.

### WELL TESTS:

Drawdown 20 ft. after hours Pumping 90 G.P.M.  
Drawdown ft. after hours G.P.M.

USE OF WATER Irrigation Temp. °F., 19

SOURCE OF INFORMATION GR-2424  
DRILLER or DIGGER J. Beck

### ADDITIONAL DATA:

Log  Water Level Measurements Chemical Analysis Aquifer Test

### REMARKS:

Topsoil & sand 23 23  
Cement gravel & boulders 37 60  
Brown gravel (water) 20 80  
Cement gravel 4 84