

STATE ENGINEER
Salem, Oregon

CLAC
C-9749

Well Record


STATE WELL NO. 3/1-28G
COUNTY Clackamas
APPLICATION NO. GR-3997

OWNER: Charles R. Achilles
MAILING ADDRESS: Route 3, Box 425 A

LOCATION OF WELL: Owner's No. _____
CITY AND STATE: Canby, Oregon

SW 1/4 NE 1/4 Sec. 28 T. 3 S., R. 1 E., W.M.

Bearing and distance from section or subdivision
corner N. 660' E. 150' S. 125' from Center Sec. 28

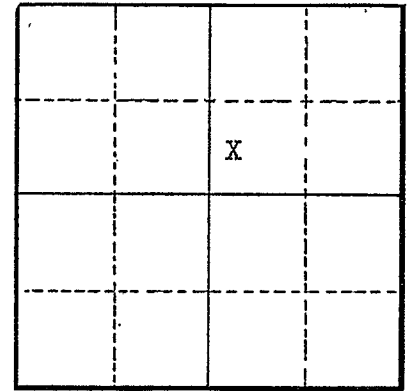

Section 28

Altitude at well _____

TYPE OF WELL: Drilled Date Constructed 6/1/46

Depth drilled 84 ft. Depth cased _____

CASING RECORD:

FINISH:

AQUIFERS:

WATER LEVEL:

47 feet below surface

PUMPING EQUIPMENT: Type Fairbanks Morse H.P. 3
Capacity 50 G.P.M.

WELL TESTS:

Drawdown 18 ft. after _____ hours 50 G.P.M.
Drawdown _____ ft. after _____ hours _____ G.P.M.

USE OF WATER Irrigation Temp. _____ °F., 19
SOURCE OF INFORMATION Well Registration Statement Cert. # GR-3604

DRILLER or DIGGER Beck

ADDITIONAL DATA:

Log Water Level Measurements _____ Chemical Analysis _____ Aquifer Test _____

REMARKS:

	Thickness	Depth to Bottom
Log		
Top soil & sand	22	0-22
Cement gravel & boulders	35	22-57
Brown gravel	7	57-64
Cement gravel & boulders	14	64-78
Blue gravel (water)	6	78-84