

STATE ENGINEER
Salem, Oregon

CLAC
9750

Well Record

STATE WELL NO. 3/1-28E
COUNTY Clackamas
APPLICATION NO. GR-1816

GR- 1757

OWNER: Jacob John Hauck


MAILING ADDRESS: 2836 S.E. 15th Ave.

LOCATION OF WELL: Owner's No.

CITY AND STATE: Portland 2, Oregon

SW 1/4 NW 1/4 Sec. 28 T. 3 S, R. 1 E, W.M.

Bearing and distance from section or subdivision corner 100' S. & 55' W. from NE cor. SW 1/4 NW 1/4 of Section 28.

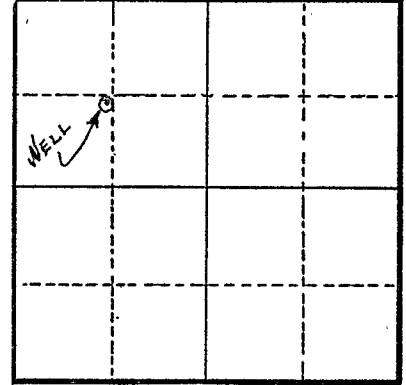

Section 28

Altitude at well

TYPE OF WELL: Drilled. Date Constructed 1954

Depth drilled 180' Depth cased 180'

CASING RECORD:

7"

FINISH:

Perforated from bottom to 55' up.

AQUIFERS:

WATER LEVEL:

47'

PUMPING EQUIPMENT: Type Sumo submersible H.P. 3
Capacity 45.6 G.P.M.

WELL TESTS:

Drawdown 106 ft. after hours 125 G.P.M.
Drawdown ft. after hours G.P.M.

USE OF WATER Irrigation Temp. °F., 19

SOURCE OF INFORMATION GR Record

DRILLER or DIGGER J. W. Beck

ADDITIONAL DATA:

Log Water Level Measurements Chemical Analysis Aquifer Test

REMARKS:

Log: Sandy silt 0 to 63 ft.
Gravel 63 to 98 ft.
Clay layer then sand & gravel 98 to 108 ft.
Clay & sand layer 108 to 140 ft.
Sand 140 to 180 ft.

Irrigation of 9 acres.