

STATE ENGINEER  
Salem, Oregon

CLAC  
009751

# Well Record


STATE WELL NO. 3/1-28G  
COUNTY CLACKAMAS  
APPLICATION NO. GR-2336

OWNER: James R. McLain & Harley Blanchard Mailing ADDRESS: Route 3 Box 428

LOCATION OF WELL: Owner's No. CITY AND STATE: Canby

SW 1/4 NE 1/4 Sec. 28 T. 3 S., R. 1 E., W.M.

Bearing and distance from section or subdivision  
corner 640' E & 100' N from center of Sec. 28  
T3S, R1E.

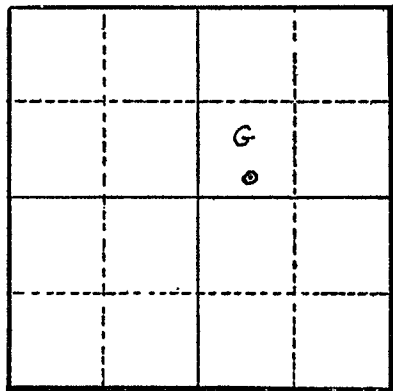

Section 28

Altitude at well

TYPE OF WELL: Drilled Date Constructed 1947

Depth drilled 165' Depth cased 165'

### CASING RECORD:

6-inch

### FINISH:

3/8 x 1 1/2 stolls 5 per ft 3 rows 58' to 126'

### AQUIFERS:

### WATER LEVEL:

PUMPING EQUIPMENT: Type Turbine H.P. 105  
Capacity 105 G.P.M.

WELL TESTS:  
Drawdown 5 ft. after hours 85 G.P.M.  
Drawdown 10 ft. after hours 150 G.P.M.

USE OF WATER Irrigation Temp. °F., 19

SOURCE OF INFORMATION GR-3874

DRILLER or DIGGER

ADDITIONAL DATA:  
Log  Water Level Measurements  Chemical Analysis  Aquifer Test

### REMARKS: