


STATE ENGINEER  
Salem, Oregon

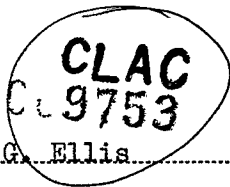

# Well Record

STATE WELL NO. 3/1-28 L  
COUNTY Clackamas  
APPLICATION NO. GR-4200

OWNER: Mrs. Merton G. Ellis


MAILING ADDRESS: Canby, Oregon

LOCATION OF WELL: Owner's No.

CITY AND STATE:

NE 1/4 SW 1/4 Sec. 28 T. 3 S, R. 1 W., W.M.

Bearing and distance from section or subdivision corner 1700' E & 1450' N from SW corner Sec 28

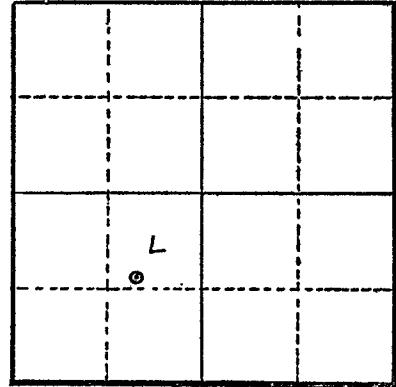

Section 28

Altitude at well

TYPE OF WELL: Drilled Date Constructed 1927

Depth drilled 120' Depth cased

### CASING RECORD:

6"

### FINISH:

12" screen 1/4" slots 100 slots to the inch

### AQUIFERS:

### WATER LEVEL:

90'

PUMPING EQUIPMENT: Type Turbine H.P. 5  
Capacity 400 G.P.M.

### WELL TESTS:

Drawdown 10 ft. after 400 hours G.P.M.

Drawdown ft. after hours G.P.M.

USE OF WATER Irrigation Temp. °F., 19

SOURCE OF INFORMATION GR-3991

DRILLER or DIGGER deceased

### ADDITIONAL DATA:

Log NA Water Level Measurements Chemical Analysis Aquifer Test

### REMARKS: