

STATE ENGINEER
Salem, Oregon

CLAC
009754

Well Record


STATE WELL NO. 3/1-28P
COUNTY CLACKAMAS
APPLICATION NO. GR-3870

OWNER: Chester W. Tompkins
MAILING ADDRESS: Rt. 3, Box 440

LOCATION OF WELL: Owner's No. _____
CITY AND STATE: Oregon

SE 1/4 SW 1/4 Sec. 28 T. 3 S., R. 1 E., W.M.

Bearing and distance from section or subdivision
corner about 2050' E & 210' N from SW cor Sec 28

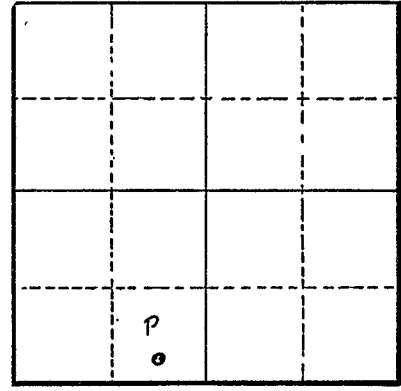

Section 28

Altitude at well _____

TYPE OF WELL: Drilled Date Constructed _____

Depth drilled 106' Depth cased _____

CASING RECORD:

5. 7/8 - inch

FINISH:

AQUIFERS:

WATER LEVEL:

67'

PUMPING EQUIPMENT: Type Jacuzzi H.P. 2
Capacity 30 G.P.M.

WELL TESTS:

Drawdown _____ ft. after _____ hours 30 G.P.M.
Drawdown _____ ft. after _____ hours _____ G.P.M.

USE OF WATER Irrigation Temp. _____ °F. _____, 19

SOURCE OF INFORMATION GR-3926

DRILLER or DIGGER Peter Hornick

ADDITIONAL DATA:

Log NA Water Level Measurements _____ Chemical Analysis _____ Aquifer Test _____

REMARKS: