

STATE ENGINEER
Salem, Oregon

CLAC
009756

Well Record

STATE WELL NO. 3/1-28Q(1)
COUNTY Clackamas
APPLICATION NO. GR-552

OWNER: Jesse E. and Hazel M. Farnsworth
MAILING ADDRESS: _____

LOCATION OF WELL: Owner's No. _____
CITY AND STATE: Canby, Oregon


SW ¼ SE ¼ Sec. 28 T. 3 N. S, R. 1 E. W., W.M.

Bearing and distance from section or subdivision corner _____

Altitude at well _____

TYPE OF WELL: Drilled Date Constructed 1/2/46

Depth drilled 120 Depth cased 120

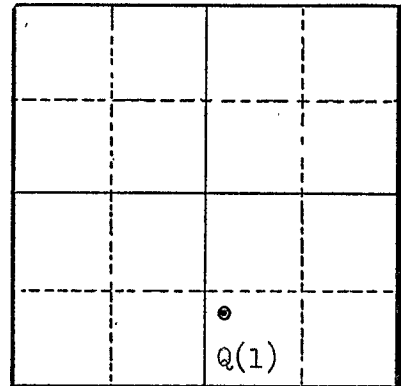

Section 28

CASING RECORD:

8-inch

FINISH:

AQUIFERS:

WATER LEVEL:

60'

PUMPING EQUIPMENT: Type Johnston turbine H.P. 5
Capacity 90 G.P.M.

WELL TESTS:

Drawdown 17 ft. after 125 hours G.P.M.

Drawdown _____ ft. after _____ hours G.P.M.

USE OF WATER Irrigation 8 acres Temp. _____ °F., 19

SOURCE OF INFORMATION GR-552

DRILLER or DIGGER A. L. Ziesing, deceased

ADDITIONAL DATA:

Log _____ Water Level Measurements _____ Chemical Analysis _____ Aquifer Test _____

REMARKS: