


STATE ENGINEER
Salem, Oregon

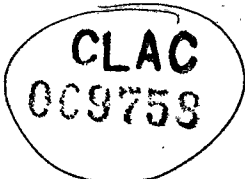

Well Record


STATE WELL NO. 3/1-28R
COUNTY Clackamas
APPLICATION NO. GR-3994

OWNER: C. C. Lamb MAILING ADDRESS: Route 3, Box 344

LOCATION OF WELL: Owner's No. _____ CITY AND STATE: Canby, Oregon

SW $\frac{1}{4}$ SW $\frac{1}{4}$ Sec. 28 T. 3 S., R. 1 W., W.M.

Bearing and distance from section or subdivision corner N. 48°15' E., 1235 ft. from SW Cor. Sec. 28

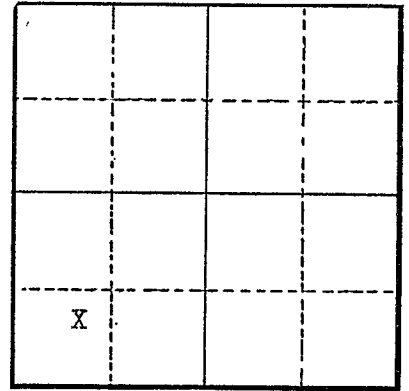

Section 28

Altitude at well _____

TYPE OF WELL: Drilled Date Constructed _____

Depth drilled 117 ft. Depth cased _____

CASING RECORD:

FINISH:

AQUIFERS:

WATER LEVEL:

80 feet below surface

PUMPING EQUIPMENT: Type Peerless High lift H.P. 2
Capacity 40 G.P.M.

WELL TESTS:

Drawdown _____ ft. after _____ hours _____ G.P.M.
Drawdown _____ ft. after _____ hours _____ G.P.M.

USE OF WATER Domestic & Irrigation Temp. _____ °F. _____, 19.

SOURCE OF INFORMATION Well Registration Statement Cert. # GR-3601

DRILLER or DIGGER _____

ADDITIONAL DATA:

Log _____ Water Level Measurements _____ Chemical Analysis _____ Aquifer Test _____

REMARKS: