

STATE ENGINEER  
Salem, Oregon

CLAC Well Record  
009778

STATE WELL NO. 3/1-29H  
COUNTY Clackamas  
APPLICATION NO. GR-4019

OWNER: Charley J. Sandsness

MAILING ADDRESS:


LOCATION OF WELL: Owner's No.

CITY AND STATE:

Canby, Oregon

SE 1/4 NE 1/4 Sec. 29 T. 3 S., R. 1 E. W.M.

Bearing and distance from section or subdivision corner 2500' S. & 1200' W. from NE Cor. Sec. 29

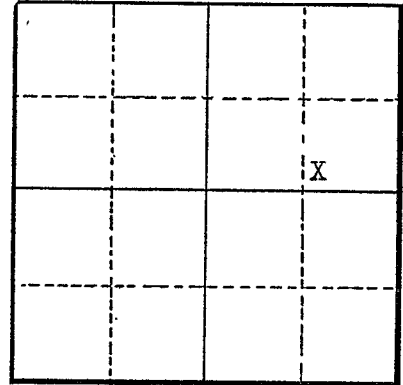

Section 29

Altitude at well

TYPE OF WELL: Drilled Date Constructed

Depth drilled 60 feet Depth cased 60 feet

CASING RECORD:

6 inch casing set to 60 feet

FINISH:

AQUIFERS:

WATER LEVEL:

PUMPING EQUIPMENT: Type Myers jet H.P. 2  
Capacity 25 G.P.M.

WELL TESTS:

Drawdown ft. after hours G.P.M.

Drawdown ft. after hours G.P.M.

USE OF WATER Irrigation Temp. °F. 19

SOURCE OF INFORMATION Well Registration Statement Cert. # GR-3622

DRILLER or DIGGER Pete Harnig (deceased)

ADDITIONAL DATA:

Log Water Level Measurements Chemical Analysis Aquifer Test

REMARKS: