

STATE ENGINEER
Salem, Oregon

CLAC
C: 9779


Well Record

STATE WELL NO. 3/1-29H(1)
COUNTY Clackamas
APPLICATION NO. GR-505

OWNER: James E. Gott
MAILING ADDRESS: Route 1, Box 606

LOCATION OF WELL: Owner's No.
CITY AND STATE: Port Orchard, Oregon

SE 1/4 NE 1/4 Sec. 29 T. 3 N. S, R. 1 E, W.M.
Bearing and distance from section or subdivision
corner Beginning point 83.7' S. 1317.8' E. and
294.6' S. from NW corner of SW 1/4 of NW 1/4 of
Section 28

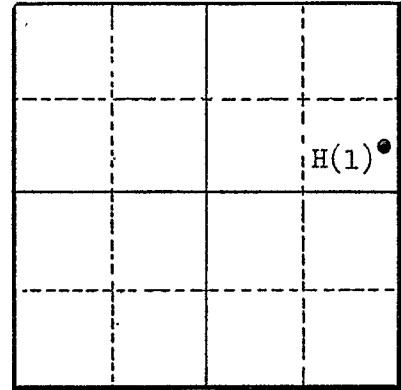

Altitude at well 133

TYPE OF WELL: Drilled Date Constructed May 20, '50

Depth drilled 144 Depth cased 144

Section 29

CASING RECORD:

6-inch I. D.

FINISH:

AQUIFERS:

WATER LEVEL:

46

PUMPING EQUIPMENT: Type Peerless "Champion" turbine H.P. 3
Capacity 50 (approx.) G.P.M.

WELL TESTS:

Drawdown 80 ft. after hours 200 G.P.M.
Drawdown 120 ft. after hours 300 G.P.M.

USE OF WATER Irrigation 13 acres Temp. °F. 19

SOURCE OF INFORMATION GR-503

DRILLER or DIGGER

ADDITIONAL DATA:

Log Water Level Measurements Chemical Analysis Aquifer Test

REMARKS: