

STATE ENGINEER
Salem, Oregon

CLAC
009782 Well Record

STATE WELL NO. 3/1-29R
COUNTY Clackamas
APPLICATION NO. GR-3055

OWNER: Fred DeForest


MAILING ADDRESS: Route 3, Box 363

LOCATION OF WELL: Owner's No. _____

CITY AND STATE: Canby, Oregon

SE $\frac{1}{4}$ SE $\frac{1}{4}$ Sec. 29 T. 3 S., R. 1 W., W.M.

Bearing and distance from section or subdivision
corner 500 feet W. & 800 feet N. of Tax Lot
42 C. Pendleton DLC 58

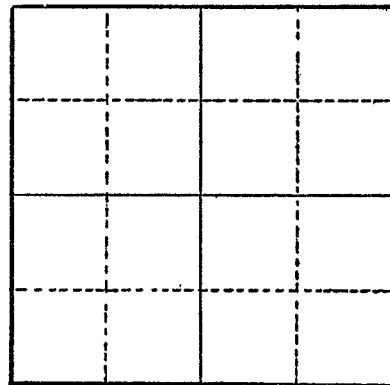

Section _____

Altitude at well _____

TYPE OF WELL: Drilled Date Constructed 1947

Depth drilled 79 feet Depth cased 79 feet

CASING RECORD:
6-inch

FINISH:

AQUIFERS:
Sand, gravel, and clay

WATER LEVEL:
60 feet

PUMPING EQUIPMENT: Type Jacuzzi 2 H. Jet H.P. 2
Capacity 30 G.P.M.

WELL TESTS:
Drawdown 5 ft. after _____ hours Pumping 24 G.P.M.
Drawdown _____ ft. after _____ hours _____ G.P.M.

USE OF WATER Irrigation Temp. _____ °F., 19 _____

SOURCE OF INFORMATION GR-2861

DRILLER or DIGGER Steinman Brothers

ADDITIONAL DATA:
Log Water Level Measurements _____ Chemical Analysis _____ Aquifer Test _____

REMARKS:

Yellow packed sand	0	20
Sand and gravel	20	38
Coarse loose gravel	38	58
Packed sand. Some gravel	58	70
Fine loose gravel	70	78
Yellow sandy clay	78	79