

STATE ENGINEER  
Salem, Oregon

CLAT  
240

# Well Record


STATE WELL NO. 8N/6W-22R(1)  
COUNTY Clatsop  
APPLICATION NO. GR-271

OWNER: Wauna Lumber Co. % W.T. Evenson, President  
MAILING ADDRESS: \_\_\_\_\_

LOCATION OF WELL: Owner's No. 1  
CITY AND STATE: Wauna, Oregon

SE 1/4 SE 1/4 Sec. 22 T. 8 N. R. 6 W., W.M.

Bearing and distance from section or subdivision  
corner N. 4° 11' W. 2735' from S<sup>1</sup>/<sub>4</sub> Cor. between  
sections 26 & 27

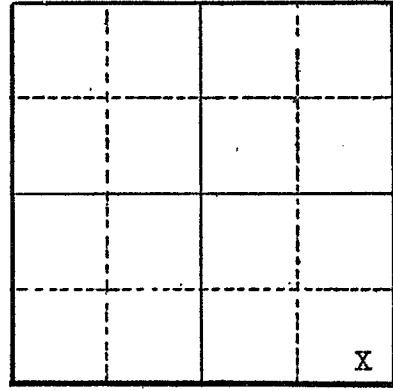

Altitude at well 25 ft. Interpolated

TYPE OF WELL: Drilled Date Constructed Nov. 1, 1949

Depth drilled 60 Depth cased 35

Section 22

CASING RECORD: 10 inch casing from (+) 25 to (-) 35 ft.

FINISH: none

AQUIFERS: unknown

WATER LEVEL: 40 ft. below land surface Dec. 1, 1949

PUMPING EQUIPMENT: Type Cook turbine H.P. 15  
Capacity 500 G.P.M.

WELL TESTS:  
Drawdown 5 ft. after \_\_\_\_\_ hours pumping 500 G.P.M.  
Drawdown \_\_\_\_\_ ft. after \_\_\_\_\_ hours \_\_\_\_\_ G.P.M.

USE OF WATER Industrial Mill use (400 <sup>gpm</sup>) Temp. \_\_\_\_\_ °F., 19

SOURCE OF INFORMATION Reg. Statement GR-271

DRILLER or DIGGER Pacific Drilling Co.

ADDITIONAL DATA:  
Log No Water Level Measurements \_\_\_\_\_ Chemical Analysis \_\_\_\_\_ Aquifer Test \_\_\_\_\_

REMARKS: