

STATE ENGINEER
Salem, Oregon

Well Record

colu 1029
STATE WELL NO. 4N/4W-3F
COUNTY Columbia
APPLICATION NO. GR-3635

OWNER: Albert F. Schalock

MAILING

ADDRESS:

Mist Route

LOCATION OF WELL: Owner's No.

CITY AND


STATE:

Vernonia, Oregon

SE 1/4 NW 1/4 Sec. 3 T. 4 N. 4 E. R. 4 W., W.M.

Bearing and distance from section or subdivision

corner 4501 N. & 3251 W. of 1/4 Sec. Cor.

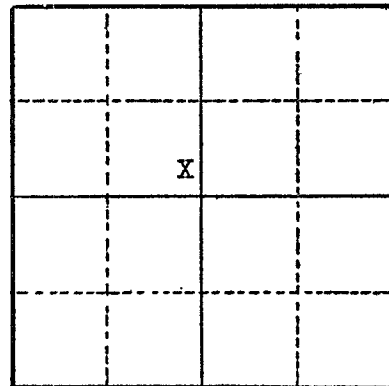

Altitude at well

TYPE OF WELL: Drilled Date Constructed

Depth drilled 42 feet Depth cased 42 feet

Section 3

CASING RECORD:

6 inch metal casing set to 42 feet

FINISH:

AQUIFERS:

WATER LEVEL:

Flowing

PUMPING EQUIPMENT: Type None siphon

H.P.

Capacity .75 G.P.M.

WELL TESTS:

Drawdown ft. after hours G.P.M.

Drawdown ft. after hours G.P.M.

USE OF WATER Domestic Temp. °F., 19

SOURCE OF INFORMATION Well Registration Statement

DRILLER or DIGGER

ADDITIONAL DATA:

Log Water Level Measurements Chemical Analysis Aquifer Test

REMARKS: