

STATE ENGINEER
Salem, Oregon

Well Record *Edy 1/19/2* STATE WELL NO. 5N/1W-8M(1)
COUNTY Columbia
APPLICATION NO. GR-604

OWNER: Elmer B. & Ida A. Loyd

MAILING

ADDRESS: Rt. 1, Box 210

LOCATION OF WELL: Owner's No. 1


CITY AND

STATE: Deer Island, Oregon

NW $\frac{1}{4}$ SW $\frac{1}{4}$ Sec. 8 T. 5 N. 1 E, R. 1 W., W.M.

Bearing and distance from section or subdivision

corner NW Cor. of prop. 700' from W $\frac{1}{4}$ Cor. Sec. 8

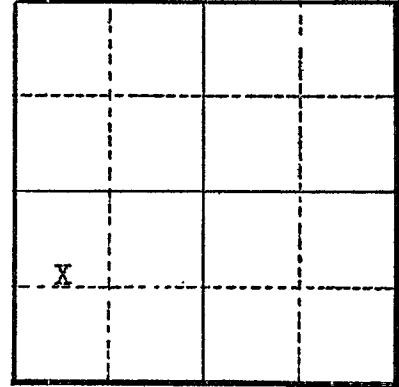

Altitude at well 65 ft. Interpolated

TYPE OF WELL: drilled Date Constructed 3/50

Depth drilled 89 ft. Depth cased 89 ft.

Section 8

CASING RECORD: 8 inch

FINISH:

AQUIFERS:

WATER LEVEL: 65 ft.

PUMPING EQUIPMENT: Type Cook turbine

H.P. 7 $\frac{1}{2}$

Capacity 120 G.P.M.

WELL TESTS:

Drawdown 10 ft. after 450 hours 450 G.P.M.

Drawdown ft. after hours G.P.M.

USE OF WATER Irrigation 54.9 ac. Temp. °F. 19

SOURCE OF INFORMATION GR-604

DRILLER or DIGGER Pacific Drilling Co.

ADDITIONAL DATA:

Log Water Level Measurements Chemical Analysis Aquifer Test

REMARKS: