

STATE ENGINEER
Salem, Oregon

Well Record *Cody*
1196

STATE WELL NO. *5N/1W-16N(1)*
COUNTY *Columbia*
APPLICATION NO. *GR-56*

OWNER: *Loyal L. Cody*

MAILING

ADDRESS: *Rt. 1*

LOCATION OF WELL: Owner's No. *1*

CITY AND

STATE: *Deer Island, Oregon*

SW $\frac{1}{4}$ *SW* $\frac{1}{4}$ Sec. *16* T. *5* N. *1* E. R. *1* W., W.M.

Bearing and distance from section or subdivision


corner

Altitude at well *63 ft. Interpolated*

TYPE OF WELL: *Sump* Date Constructed *8/10/51*

Depth drilled *6 ft.* Depth cased *--*

CASING RECORD: *None*

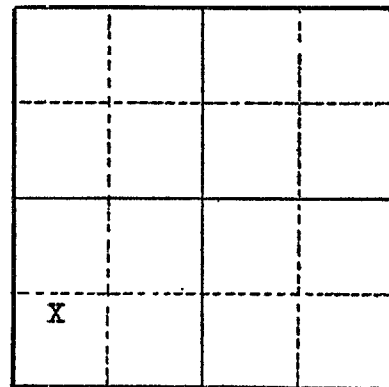

Section *16*

FINISH: *None*

AQUIFERS:

WATER LEVEL: *Variable with tide and river levels* *8/12/51*

PUMPING EQUIPMENT: Type *Fairbanks Morse* H.P. *15*
Capacity *300* G.P.M.

WELL TESTS:

Drawdown *3 in.* ~~3%~~ after *600* hours G.P.M.

Drawdown *ft.* after *hours* G.P.M.

USE OF WATER *Irrigation* *25 acres* Temp. *°F.*, *19*

SOURCE OF INFORMATION *Reg. Statement GR-56*

DRILLER or DIGGER

ADDITIONAL DATA:

Log *No* Water Level Measurements *No* Chemical Analysis *Aquifer Test*

REMARKS: *Sump - 10' x 5' x 6' 600 gpm 8/12/51*