

STATE ENGINEER  
Salem, Oregon

# Well Record

STATE WELL NO. 5N-1W-17B  
COUNTY Columbia  
APPLICATION NO. GR-3344

OWNER: George B. Miller


MAILING  
ADDRESS: Route 1

LOCATION OF WELL: Owner's No. \_\_\_\_\_

CITY AND  
STATE: Deer Island, Oregon

NW 1/4 NE 1/4 Sec. 17 T. 5 N. 1 E. W.M.

Bearing and distance from section or subdivision  
corner 550' S. and 100' E

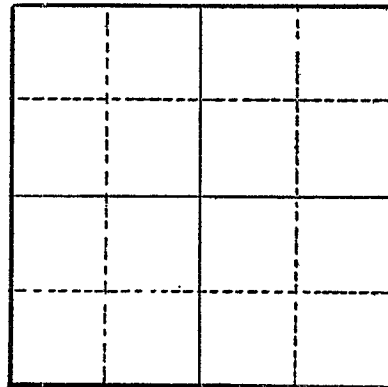

Section \_\_\_\_\_

Altitude at well \_\_\_\_\_

TYPE OF WELL: drilled Date Constructed 1955

Depth drilled 76' Depth cased 75'

CASING RECORD:

6"

FINISH:

AQUIFERS:

WATER LEVEL:

60'

PUMPING EQUIPMENT: Type Deming Pump Jet type \_\_\_\_\_ H.P. 3/4  
Capacity \_\_\_\_\_ G.P.M.

WELL TESTS:

Drawdown \_\_\_\_\_ ft. after \_\_\_\_\_ hours \_\_\_\_\_ G.P.M.

Drawdown \_\_\_\_\_ ft. after \_\_\_\_\_ hours \_\_\_\_\_ G.P.M.

USE OF WATER Irrigation Temp. \_\_\_\_\_ °F. \_\_\_\_\_, 19\_\_\_\_

SOURCE OF INFORMATION GR-3097

DRILLER or DIGGER Guy Luttrell Route 1 St. Helens, Oregon

ADDITIONAL DATA:

Log \_\_\_\_\_ Water Level Measurements \_\_\_\_\_ Chemical Analysis \_\_\_\_\_ Aquifer Test \_\_\_\_\_

REMARKS: