

STATE ENGINEER
Salem, Oregon

Well Record

STATE WELL NO. 5N/1W-28H
COUNTY COLUMBIA
APPLICATION NO. GR-2515

OWNER: City of Columbia City

MAILING
ADDRESS: _____


LOCATION OF WELL: Owner's No. _____

CITY AND
STATE: _____

Columbia City

SE 1/4 NE 1/4 Sec. 28 T. 5 N. 8, R. 1 W., W.M.

Bearing and distance from section or subdivision
corner 1500' E & 380' S from center of Sec 28

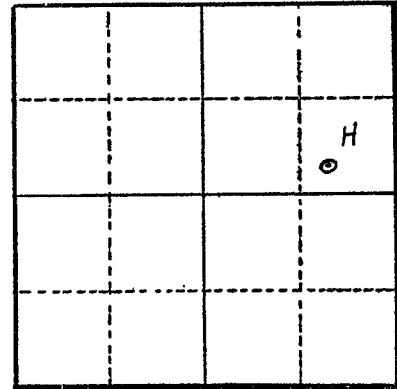

Altitude at well _____

TYPE OF WELL: Drilled Date Constructed 1939

Depth drilled 158' Depth cased _____

Section 28

CASING RECORD:

8-inch to 134' (telecom with Ed Jansen 2/11/75, F.G.L.)

FINISH:

Perforated casings (Unknown Interval)

AQUIFERS:

WATER LEVEL: First water at 102 - Small amount (per telecom with Ed Jansen 2/11/75, F.G.L.)
SWL 100'

PUMPING EQUIPMENT: Type Deming. 6 in. cup pump H.P. 15
Capacity 120 G.P.M.

WELL TESTS:

Drawdown _____ ft. after _____ hours 120 G.P.M.
Drawdown _____ ft. after _____ hours _____ G.P.M.

USE OF WATER Municipal Temp. _____ °F. _____, 19 _____

SOURCE OF INFORMATION GR-3873

DRILLER or DIGGER A. M. Jansen

ADDITIONAL DATA:

Log NA Water Level Measurements _____ Chemical Analysis _____ Aquifer Test _____

REMARKS: Log: 0 - 122 gravel
122 - 138 Boulders
138 - 140 clay
140 - 148 Rock
148 - 155 Blue sandstone } Per telecom with Ed Jansen
2/11/75, F.G.L.