


STATE ENGINEER
Salem, Oregon

Well Record *Col* STATE WELL NO. 5N/2W-25A
COUNTY Columbia
1390 APPLICATION NO. GR-4272

OWNER: Fred Luttrell MAILING ADDRESS: Route 1, Box 658
CITY AND STATE: St. Helens, Oregon

LOCATION OF WELL: Owner's No. _____
NE 1/4 NE 1/4 Sec. 25 T. 5 N. 2 E. S. R. 2 W., W.M.
Bearing and distance from section or subdivision
corner 1200 feet SW of corner of Section between 25 and
30

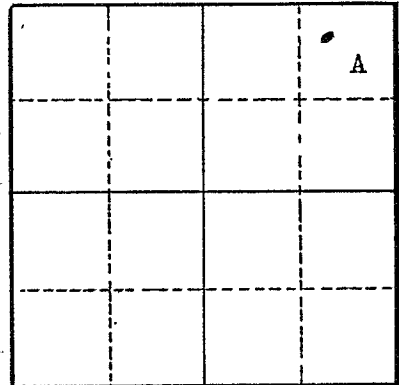

Altitude at well 260 feet

TYPE OF WELL: Drilled Date Constructed July 1950
Depth drilled 685 feet Depth cased 685 feet

Section 25

CASING RECORD:
10-inch casing set from 0 to 141 feet
open hole 141 to 685 feet

FINISH:

AQUIFERS:
sand and clay

WATER LEVEL:
231 feet

PUMPING EQUIPMENT: Type Peerless H.P. _____
Capacity 250 G.P.M.

WELL TESTS:
Drawdown 179 ft. after _____ hours 250 G.P.M.
Drawdown _____ ft. after _____ hours _____ G.P.M.

USE OF WATER Irrigation Temp. _____ °F., 19 _____

SOURCE OF INFORMATION GR-4123

DRILLER or DIGGER self

ADDITIONAL DATA:
Log Water Level Measurements _____ Chemical Analysis _____ Aquifer Test _____

REMARKS:
clay 0 to 141
basalt rock 141 to 211
blue sandstone 211 to 580
heavy granular sand (water) 580 to 685