

STATE ENGINEER
Salem, Oregon

Well Record *col 1433*

STATE WELL NO. 5N/2W-35R
COUNTY Columbia
APPLICATION NO. CR-3530

OWNER: Carl Brandenfels


MAILING ADDRESS: Box 7

LOCATION OF WELL: Owner's No. _____

CITY AND STATE: St. Helens, Oregon

SE $\frac{1}{4}$ SE $\frac{1}{4}$ Sec. 35 T. 5 N., R. 2 E. W., W.M.

Bearing and distance from section or subdivision corner 1500 ft. NW of SE corner of Sec. 35

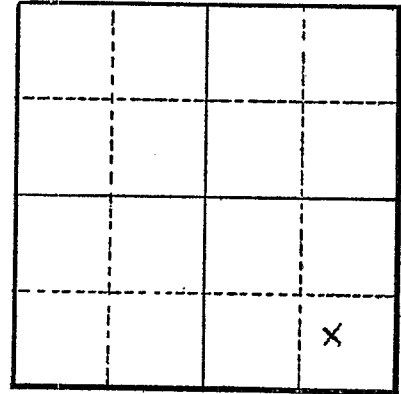

Section 35

Altitude at well _____

TYPE OF WELL: drilled Date Constructed June, 1947

Depth drilled 428 ft. Depth cased _____

CASING RECORD:

FINISH:

AQUIFERS:

WATER LEVEL:

PUMPING EQUIPMENT: Type augur type H.P. 7 $\frac{1}{2}$ & 5
Capacity _____ G.P.M.

WELL TESTS:

Drawdown _____ ft. after _____ hours 50 G.P.M.
Drawdown _____ ft. after _____ hours _____ G.P.M.

USE OF WATER Irrigation Temp. _____ °F. _____, 19____

SOURCE OF INFORMATION Well Registration Statement

DRILLER or DIGGER _____

ADDITIONAL DATA:

Log X Water Level Measurements _____ Chemical Analysis _____ Aquifer Test _____

REMARKS:

Well is artesian. Flows to top.

