

STATE ENGINEER  
Salem, Oregon

# Well Record


Coly STATE WELL NO. 5N/2W-35R  
1434 COUNTY Columbia  
APPLICATION NO. GR-3529

OWNER: Carl Brandenfels MAILING ADDRESS: Box 7

LOCATION OF WELL: Owner's No. CITY AND STATE: St. Helens, Oregon

SE 1/4 SE 1/4 Sec. 35 T. 5 N. R. 2 W., W.M.

Bearing and distance from section or subdivision corner 1500 ft. NW of SE corner of Sec. 35

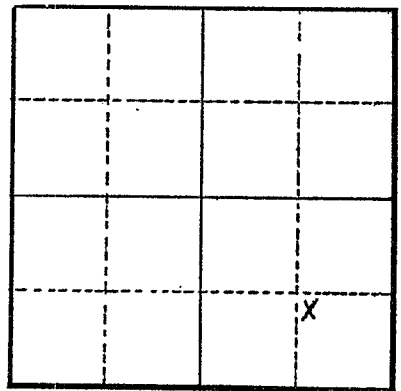

Section 35

Altitude at well

TYPE OF WELL: Dug Date Constructed Summer, 1948

Depth drilled 16 ft. Depth cased

CASING RECORD:

FINISH:

AQUIFERS:

WATER LEVEL:

9 feet below surface

PUMPING EQUIPMENT: Type 5 phase pump H.P. 5  
Capacity 75 G.P.M.

WELL TESTS:

Drawdown 3 ft. after hours 75 G.P.M.  
Drawdown ft. after hours G.P.M.

USE OF WATER Irrigation Temp. °F., 19

SOURCE OF INFORMATION Well Registration Statement

DRILLER or DIGGER

ADDITIONAL DATA:

Log X Water Level Measurements Chemical Analysis Aquifer Test

REMARKS:

