

STATE ENGINEER
Salem, Oregon

Well Record *Coly*
1436

STATE WELL NO. 5N/2W-35A
COUNTY Columbia
APPLICATION NO. GR-3294

OWNER: Charles Werings


MAILING ADDRESS: Route 1, Box 634

LOCATION OF WELL: Owner's No.

CITY AND STATE: St. Helens, Oregon

$N\frac{1}{2}$ NE $\frac{1}{4}$ NE $\frac{1}{4}$ Sec. 35 T. 5 N. S. R. 2 E. W.M.

Bearing and distance from section or subdivision corner W. 12 acres

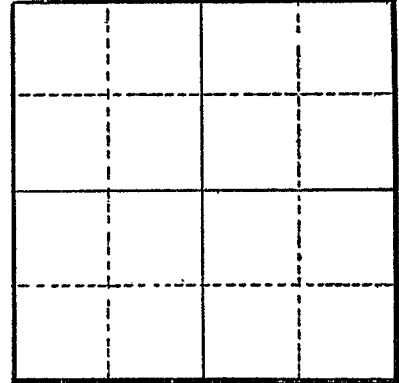

Section

Altitude at well

TYPE OF WELL: drilled Date Constructed 1949

Depth drilled 210 Depth cased 119

CASING RECORD:

6 inch

FINISH:

AQUIFERS:

WATER LEVEL:

55 feet

PUMPING EQUIPMENT: Type Doward Jet Pump H.P. 1
Capacity G.P.M.

WELL TESTS:

Drawdown ft. after hours G.P.M.
Drawdown ft. after hours G.P.M.

USE OF WATER irrigation Temp. °F., 19

SOURCE OF INFORMATION GR-3059

DRILLER or DIGGER McKnight

ADDITIONAL DATA:

Log Water Level Measurements Chemical Analysis Aquifer Test

REMARKS: