

STATE ENGINEER
Salem, Oregon

Well Record

STATE WELL NO. 7N/3W-5J
COUNTY Columbia
APPLICATION NO. GR-3924

OWNER: Joseph F. Bergman

MAILING

ADDRESS: Route 1, Box 242

CITY AND

STATE: Clatskanie, Oregon

LOCATION OF WELL: Owner's No. _____

NE $\frac{1}{4}$ SE $\frac{1}{4}$ Sec. 5 T. 7 N. 3, R. 3 E. W., W.M.


Bearing and distance from section or subdivision
corner 650' S. & 1350' E. of center of Sec. 5

Altitude at well _____

TYPE OF WELL: Drilled Date Constructed 6/20/52

Depth drilled 158 ft. Depth cased _____

CASING RECORD:

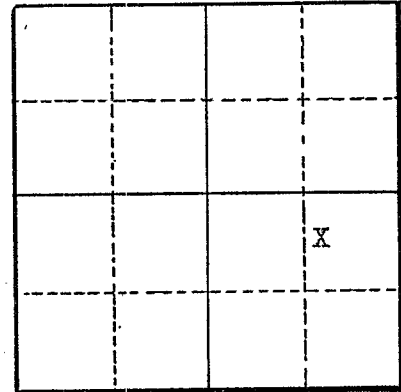

Section 5

FINISH:

AQUIFERS:

WATER LEVEL:

100 feet of water standing in the hole

PUMPING EQUIPMENT: Type Jacuzzi vertical H.P. 1
Capacity 25 G.P.M.

WELL TESTS:

Drawdown _____ ft. after _____ hours _____ G.P.M.

Drawdown _____ ft. after _____ hours _____ G.P.M.

USE OF WATER Irrigation Temp. _____ °F., 19 _____

SOURCE OF INFORMATION Well Registration Statement Cert. # GR-3560

DRILLER or DIGGER McGhee's Well Drilling

ADDITIONAL DATA:

Log _____ Water Level Measurements _____ Chemical Analysis _____ Aquifer Test _____

REMARKS: