


Middleton, James

27	26
34	35

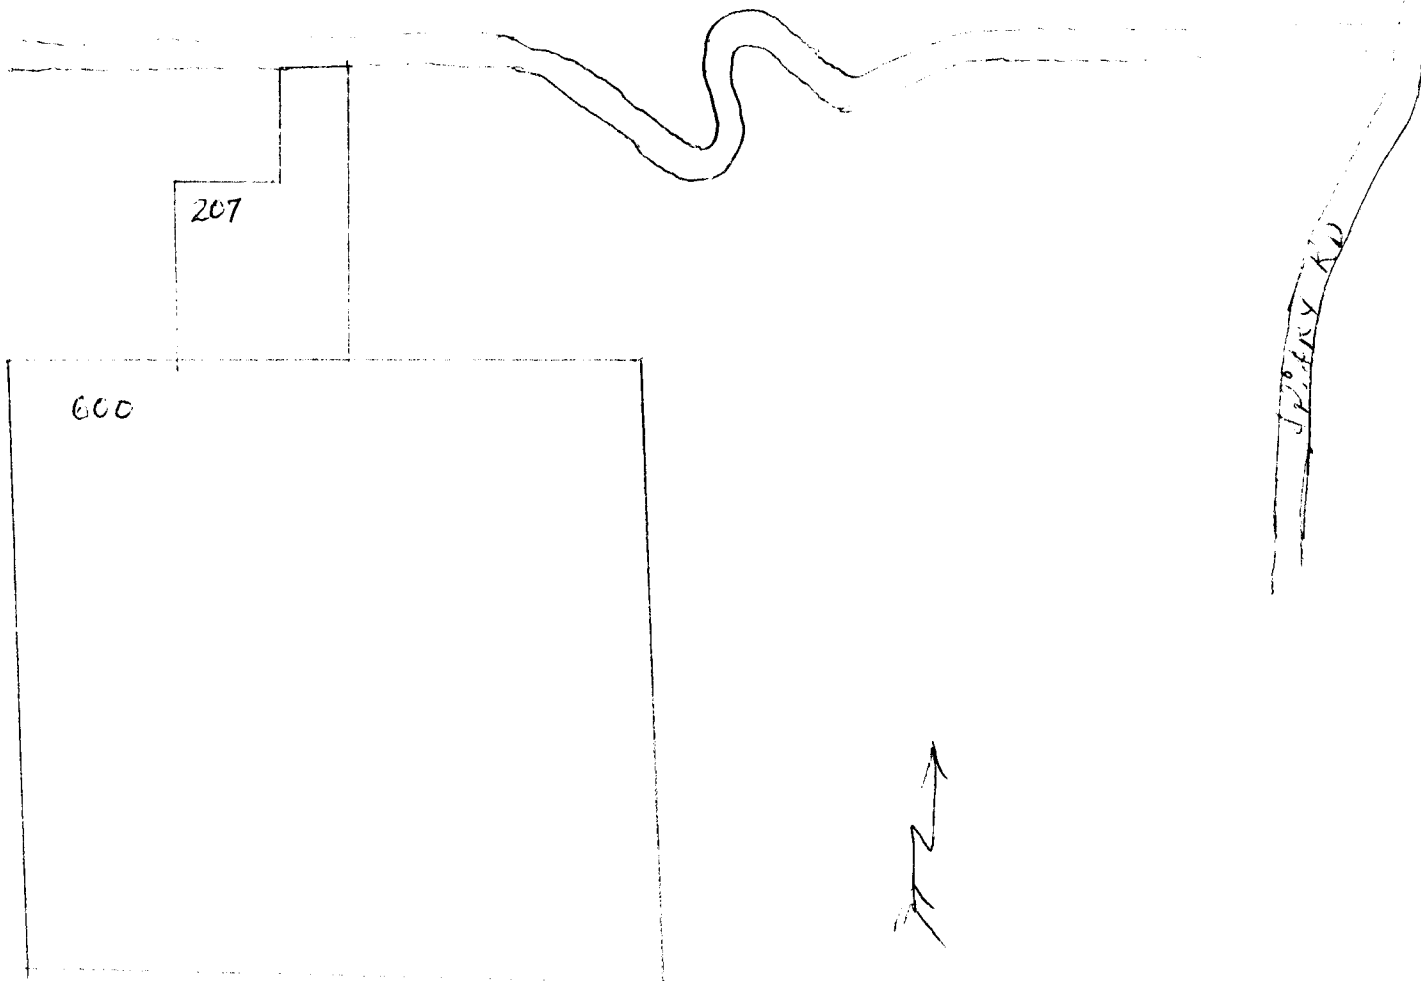

7/3-34 a b c
b
a c