


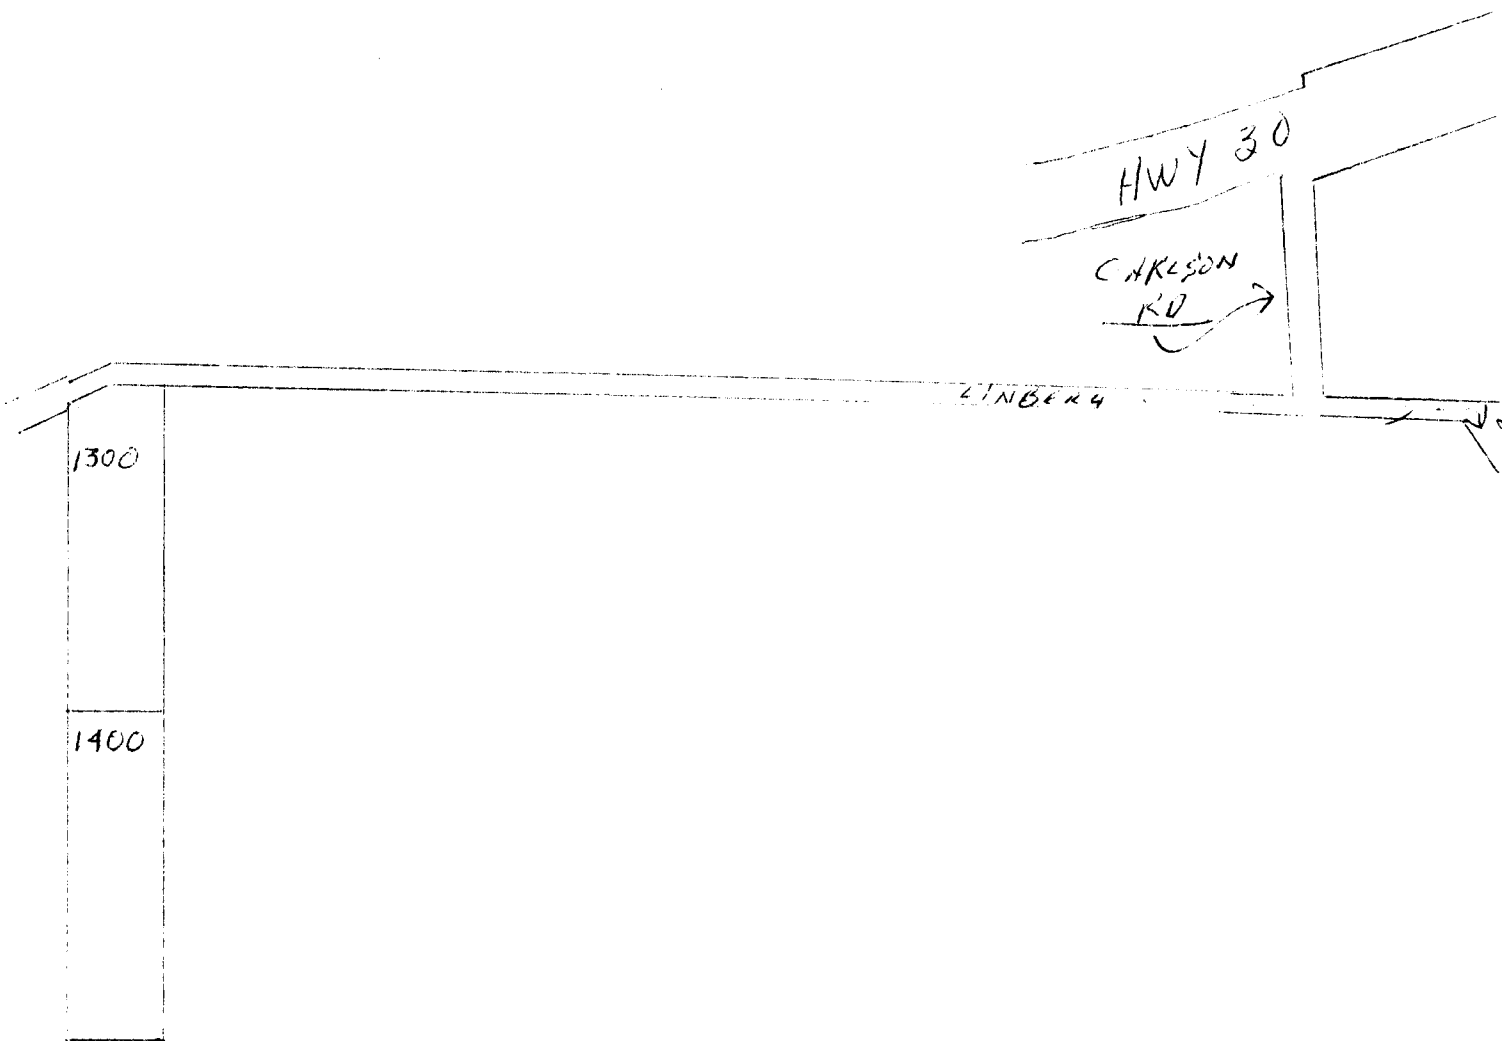

Roller, Don



7/4-13 c b b

