

NOTICE TO WATER WELL CONTRACTOR  
The original and first copy of this report  
are to be filed with the

WATER RESOURCES DEPARTMENT.  
SALEM, OREGON 97310  
within 30 days from the date  
of well completion.

**RECEIVED REPORT**  
**STATE OF OREGON**

JUL 1 1978  
(Please type or print)  
(Do not write above this line)

**COLU**

**2541**

State Well No. **7N14W-22**

State Permit No. \_\_\_\_\_

VIOLATION DEPT.

SALEM, OREGON

**(1) OWNER:**

Name Kelso Gospel Tabernacle, Inc.  
Address 1209 Minor Rd.  
Kelso, Washington 98626

**(2) TYPE OF WORK (check):**

New Well  Deepening  Reconditioning  Abandon   
If abandonment, describe material and procedure in Item 12.

**(3) TYPE OF WELL:**

Rotary  Driven   
Cable  Jetted   
Dug  Bored

**(4) PROPOSED USE (check):**

Domestic  Industrial  Municipal   
Irrigation  Test Well  Other

**(5) CASING INSTALLED:**

Threaded  Welded   
6" Diam. from 1'6" ft. to 118 ft. Gage .250  
" Diam. from \_\_\_\_\_ ft. to \_\_\_\_\_ ft. Gage \_\_\_\_\_  
" Diam. from \_\_\_\_\_ ft. to \_\_\_\_\_ ft. Gage \_\_\_\_\_

**(6) PERFORATIONS:**

Perforated?  Yes  No.  
Type of perforator used Torch-Cut  
Size of perforations 3/8 in. by 6 in.  
20 perforations from 88 ft. to 118 ft.  
perforations from \_\_\_\_\_ ft. to \_\_\_\_\_ ft.  
perforations from \_\_\_\_\_ ft. to \_\_\_\_\_ ft.

**(7) SCREENS:**

Well screen installed?  Yes  No  
Manufacturer's Name \_\_\_\_\_  
Type \_\_\_\_\_ Model No. \_\_\_\_\_  
Diam. \_\_\_\_\_ Slot size \_\_\_\_\_ Set from \_\_\_\_\_ ft. to \_\_\_\_\_ ft.  
Diam. \_\_\_\_\_ Slot size \_\_\_\_\_ Set from \_\_\_\_\_ ft. to \_\_\_\_\_ ft.

**(8) WELL TESTS:**

Drawdown is amount water level is lowered below static level  
Was a pump test made?  Yes  No If yes, by whom? Driller  
Yield: 27 gal./min. with 98'6" ft. drawdown after 1 hrs.  
Air rotary tested at 117'  
" " " " " "  
Bailer test \_\_\_\_\_ gal./min. with \_\_\_\_\_ ft. drawdown after \_\_\_\_\_ hrs.  
Artesian flow \_\_\_\_\_ g.p.m.  
Temperature of water \_\_\_\_\_ Depth artesian flow encountered \_\_\_\_\_ ft.

**(9) CONSTRUCTION:**

Well seal—Material used Cement Grout  
Well sealed from land surface to 44 ft.  
Diameter of well bore to bottom of seal 10 in.  
Diameter of well bore below seal 10 in.  
Number of sacks of cement used in well seal 52 sacks  
How was cement grout placed? trimming pipe run down to 44', pumped in cement grout 100 psi and then back pulled 10" casing  
Was a drive shoe used?  Yes  No Plugs \_\_\_\_\_ Size: location \_\_\_\_\_ ft.  
Did any strata contain unusable water?  Yes  No  
Type of water? \_\_\_\_\_ depth of strata \_\_\_\_\_  
Method of sealing strata off \_\_\_\_\_  
Was well gravel packed?  Yes  No Size of gravel: 1/2  
Gravel placed from 44 ft. to 101 ft.

**(10) LOCATION OF WELL:**

County Columbia Driller's well number \_\_\_\_\_  
\_\_\_\_\_ 1/4 Section 22 T. 7N R. 4W W.M. \_\_\_\_\_  
Bearing and distance from section or subdivision corner \_\_\_\_\_

**(11) WATER LEVEL: Completed well.**

Depth at which water was first found 88 ft.  
Static level 18 1/2 ft. below land surface. Date 6-29-78  
Artesian pressure 0 lbs. per square inch. Date 6-29-78

**(12) WELL LOG:**

Diameter of well below casing 0  
Depth drilled 118 ft. Depth of completed well 118 ft.

Formation: Describe color, texture, grain size and structure of materials; and show thickness and nature of each stratum and aquifer penetrated, with at least one entry for each change of formation. Report each change in position of Static Water Level and indicate principal water-bearing strata.

MATERIAL	From	To	SWL
Top Clay Brown	0	12	
Boulders	12	16	
Clay Brown	16	26	
Sandstone Blue-Gray	26	74	
Sandstone Gray Soft	74	85	
Sandstone Crumbly	85	97	
Shale Blue Gray	97	105	
Sandstone Soft Gray	105	118	

Work started 6-29 1978 Completed 6-30 1978  
Date well drilling machine moved off of well 7-1 1978

**Drilling Machine Operator's Certification:**

This well was constructed under my direct supervision. Materials used and information reported above are true to my best knowledge and belief.

[Signed] Dale McShee Date 7-5, 1978  
(Drilling Machine Operator)

Drilling Machine Operator's License No. 363

**Water Well Contractor's Certification:**

This well was drilled under my jurisdiction and this report is true to the best of my knowledge and belief.

Name Dale McGhee Well Drilling  
(Person, firm or corporation) (Type or print)


Address 3072 Allen St. Kelso, Wash.

[Signed] Dale McShee  
(Water Well Contractor)

Contractor's License No. 424 Date 7-5, 1978

KELSO GOSPEL TABERNACLE, INC

(Barr, John R & Wm. L.)

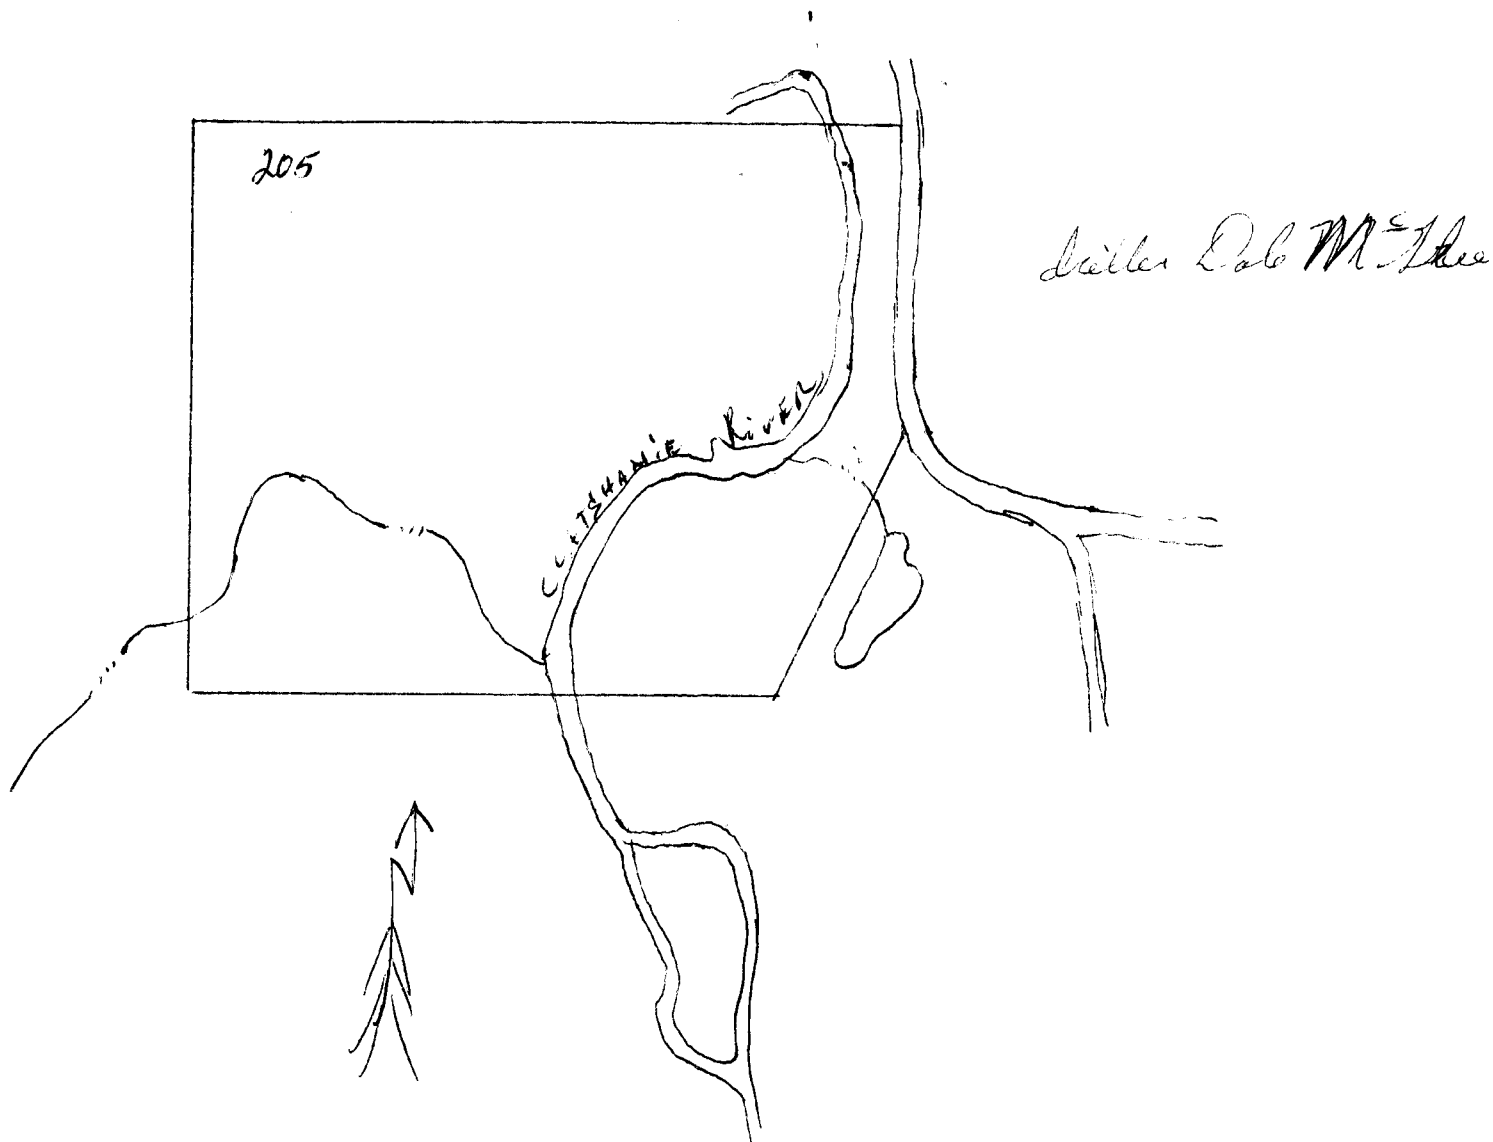

Walter Dale McThee

7/4-22 a b l e