


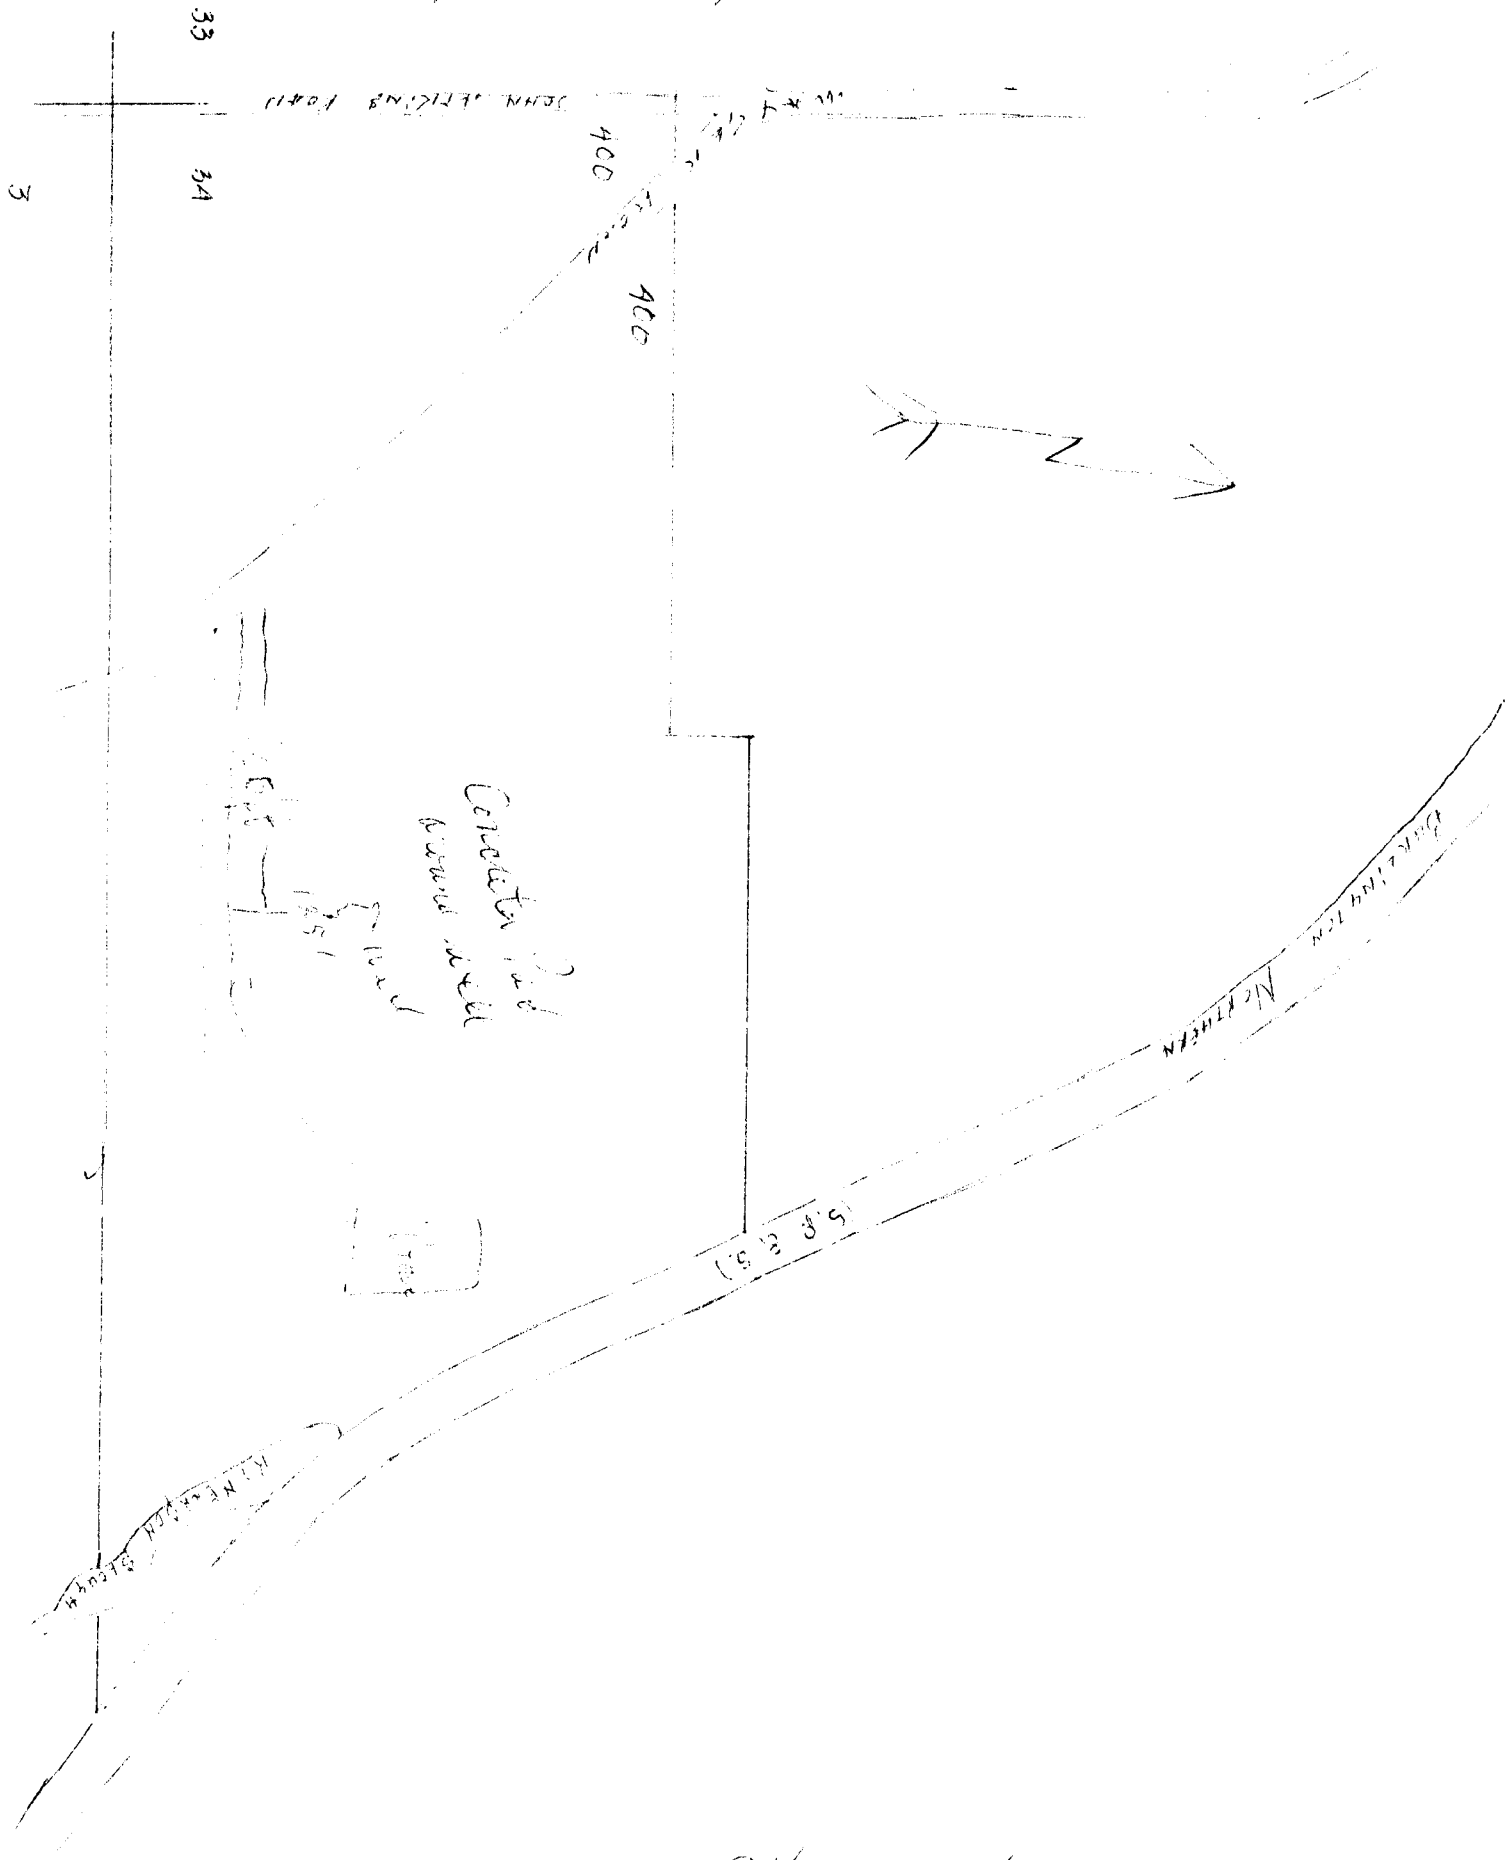

Hackburn, Richard



8N/5W - 34 C, C, C