

STATE ENGINEER
Salem, Oregon

COLU
3104

Well Record

STATE WELL NO. 3N/2W-12J
COUNTY Columbia
APPLICATION NO. GR-926

OWNER: City of Scappoose

MAILING

ADDRESS:

LOCATION OF WELL: Owner's No.

CITY AND

STATE: Scappoose, Oregon

NE 1/4 SE 1/4 Sec. 12 T. 3 N. R. 2 W., W.M.

Bearing and distance from section or subdivision


corner S. 726.51' & W. 529.78' from E1/4 Cor. Sec. 12

Altitude at well 32 ft.

TYPE OF WELL: drilled Date Constructed 1950

Depth drilled 116 ft. Depth cased 116 ft.

CASING RECORD: 8 inch 32' to 116'

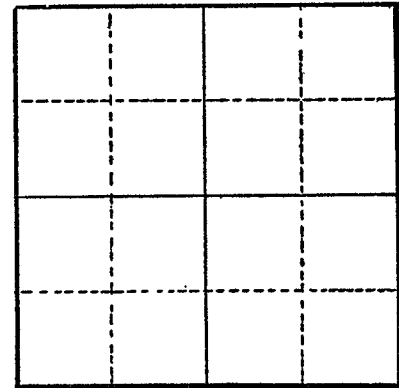

Section

FINISH: Gravel filled to 80'
Pipe perf. 50' to 60'

AQUIFERS: --

WATER LEVEL: 50 ft.

PUMPING EQUIPMENT: Type Serial #0L16651 H.P. 30 elec.
Capacity G.P.M. G.E. 1760 rpm

WELL TESTS:
Drawdown 25 ft. after hours 200 G.P.M.
Drawdown 35 ft. after hours 30 G.P.M.

USE OF WATER Municipal Temp. °F. 19

SOURCE OF INFORMATION Virginia R. Sheldon

DRILLER or DIGGER Steinman Bros.

ADDITIONAL DATA:

Log NA Water Level Measurements Chemical Analysis Aquifer Test

REMARKS: