

STATE ENGINEER  
Salem, Oregon

# Well Record

STATE WELL NO. 3N/2W-13F(1)  
COUNTY Columbia  
APPLICATION NO. GR-625

3109

OWNER: Henry G. & Laura R. Roza


MAILING ADDRESS: Rt. 1, Box 11

LOCATION OF WELL: Owner's No. 1

CITY AND STATE: Scappoose, Oregon

SE  $\frac{1}{4}$  NW  $\frac{1}{4}$  Sec. 13 T. 3 N. R. 2 W., W.M.

Bearing and distance from section or subdivision  
corner 1870' S. & 2500' E. from NW Cor. Sec. 13.

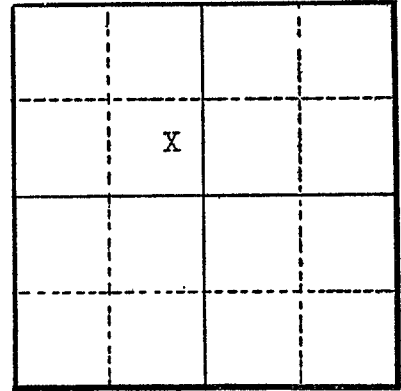

Section 13

Altitude at well 62 ft. Interpolated

TYPE OF WELL: Drilled Date Constructed 8/16/46

Depth drilled 133 ft. Depth cased 133 ft.

CASING RECORD: 6 inch

FINISH:

AQUIFERS:

WATER LEVEL: 40 ft.

PUMPING EQUIPMENT: Type Berkeley jet H.P. 3  
Capacity 20 G.P.M.

WELL TESTS:

Drawdown ..... ft. after ..... hours ..... G.P.M.  
Drawdown ..... ft. after ..... hours ..... G.P.M.

USE OF WATER dom. stk. & irrigation Temp. ..... °F. ...., 19

SOURCE OF INFORMATION GR-625

DRILLER or DIGGER owner

ADDITIONAL DATA:

Log X Water Level Measurements ..... Chemical Analysis ..... Aquifer Test .....

REMARKS:

