

STATE ENGINEER
Salem, Oregon

COLU

Well Record

STATE WELL NO. 3N/2W-130
COUNTY Columbia
APPLICATION NO. GR-619

3110

GR- 1544

OWNER: Martin J. Irtek


MAILING ADDRESS: _____

LOCATION OF WELL: Owner's No. _____

CITY AND STATE: Scappoose, Oregon

SW 1/4 SE 1/4 Sec. 13 T. 3 N. EX R. 2 W., W.M.

Bearing and distance from section or subdivision corner 100' E. & 1200' N. from S 1/4 cor. Sec. 13

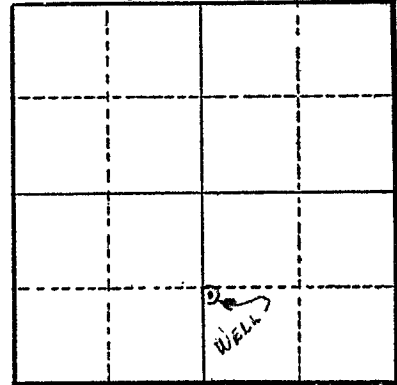

Section 13

Altitude at well _____

TYPE OF WELL: Drilled Date Constructed 1952

Depth drilled 170' Depth cased 170'

CASING RECORD:

6"

FINISH:

AQUIFERS:

WATER LEVEL:

47'

PUMPING EQUIPMENT: Type Pacific deep well turbine H.P. 3
Capacity 45 G.P.M.

WELL TESTS:

Drawdown 53 ft. after _____ hours 45 G.P.M.
Drawdown _____ ft. after _____ hours _____ G.P.M.

USE OF WATER Irrigation Temp. _____ °F. _____, 19____

SOURCE OF INFORMATION GR Record

DRILLER or DIGGER _____

ADDITIONAL DATA:

Log _____ Water Level Measurements _____ Chemical Analysis _____ Aquifer Test _____

REMARKS:

Log: Soil 0 to 14 ft.
Rock 14 to 20 ft.
Quick sand 20 to 170 ft.

Irrigation of 3.5 acres