

STATE ENGINEER
Salem, Oregon

Well Record

STATE WELL NO. 3N/2W-24Q
COUNTY Columbia
APPLICATION NO. GR-1710

3232

GR-1659

OWNER: Darrell Jones

MAILING
ADDRESS:

Rt. 1, Box 44-B


LOCATION OF WELL: Owner's No. _____

CITY AND
STATE:

Scappoose, Oregon

SW $\frac{1}{4}$ SE $\frac{1}{4}$ Sec. 24 T. 3 N. E. R. 2 W., W.M.

Bearing and distance from section or subdivision
corner 1250' N. & 75' E. from S $\frac{1}{4}$ cor. Sec. 24.

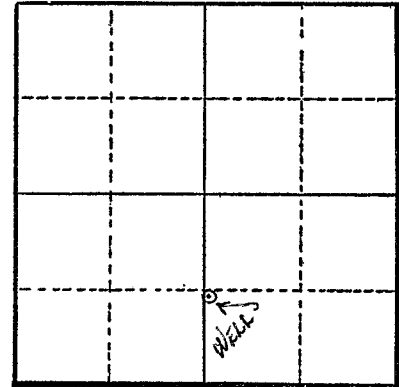

Section 24

Altitude at well 35'

TYPE OF WELL: Drilled Date Constructed 1952

Depth drilled 64' Depth cased 64'

CASING RECORD:

6"

FINISH:

AQUIFERS:

WATER LEVEL:

36'

PUMPING EQUIPMENT: Type F. M. Jet H.P. 1
Capacity 13 G.P.M.

WELL TESTS:

Drawdown _____ ft. after _____ hours _____ G.P.M.

Drawdown _____ ft. after _____ hours _____ G.P.M.

USE OF WATER Irrigation Temp. _____ °F. _____, 19_____

SOURCE OF INFORMATION GR Record

DRILLER or DIGGER _____

ADDITIONAL DATA:

Log _____ Water Level Measurements _____ Chemical Analysis _____ Aquifer Test _____

REMARKS:

Log:	Brown sandy clay	0 to 20 ft.
	Quick sand	20 to 46 ft.
	Cement gravel	46 to 49 ft.
	Sand & gravel	49 to 57 ft.
	Cement gravel	57 to 62 ft.
	Coarse water sand	62 to 64 ft.

Irrigation of 2 acres.