

STATE ENGINEER
Salem, Oregon

Well Record

STATE WELL NO. 4N/1W-7P
COUNTY COLUMBIA
APPLICATION NO. GR-3636

328

OWNER: Tony and Fannie Moros


MAILING ADDRESS: Warren

LOCATION OF WELL: Owner's No. _____

CITY AND STATE: Oregon

SE 1/4 SW 1/4 Sec. 7 T. 4 N. 1 W., W.M.

Bearing and distance from section or subdivision corner 870' N & 1600' E from SW cor Sec 7

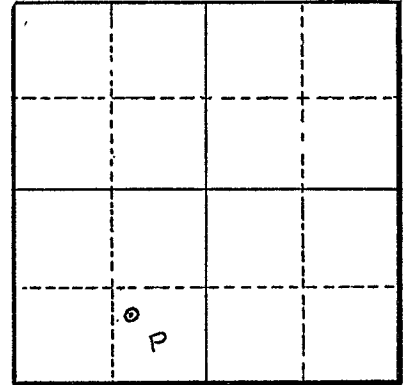

Section 7

Altitude at well _____

TYPE OF WELL: Drilled Date Constructed 1952

Depth drilled 104' Depth cased 104'

CASING RECORD:

6-inch

FINISH:

AQUIFERS:

WATER LEVEL:

27'

PUMPING EQUIPMENT: Type Berkeley Jet H.P. 3
Capacity 25 G.P.M.

WELL TESTS:

Drawdown 25-30 ft. after _____ hours _____ G.P.M.
Drawdown _____ ft. after _____ hours _____ G.P.M.

USE OF WATER Irrigation Temp. _____ °F. _____, 19_____

SOURCE OF INFORMATION GR-3950

DRILLER or DIGGER Fred Luttrell

ADDITIONAL DATA:

Log NA Water Level Measurements _____ Chemical Analysis _____ Aquifer Test _____

REMARKS: