

STATE ENGINEER  
Salem, Oregon

**COLU**  
3283

# Well Record

STATE WELL NO. 4N/1W-7R(1)  
COUNTY Columbia  
APPLICATION NO. GR-1040

GR- 1003

OWNER: Walter Rinehart

MAILING  
ADDRESS:

Rt. 1, Box 481

LOCATION OF WELL: Owner's No. \_\_\_\_\_

CITY AND  
STATE:

Warren, Oregon


SE ¼ SE ¼ Sec. 7 T. 4 N. 1 W., W.M.

Bearing and distance from section or subdivision  
corner 400' N. & 180' W. of SE cor. of Sec. 7.

Altitude at well 100 ft.

TYPE OF WELL: Drilled Date Constructed 1954

Depth drilled 69 ft. Depth cased 69 ft.

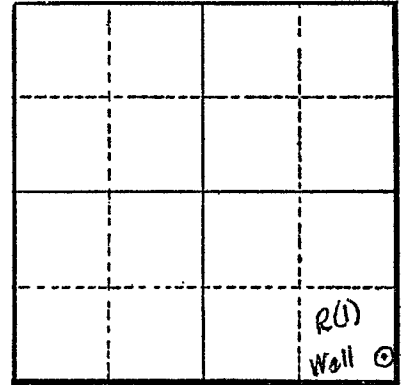

Section 7

### CASING RECORD:

6 inch

### FINISH:

### AQUIFERS:

### WATER LEVEL:

60 ft.

PUMPING EQUIPMENT: Type Myers H.P. 3/4  
Capacity 10 G.P.M.

### WELL TESTS:

Drawdown 6 ft. after \_\_\_\_\_ hours 12 G.P.M.  
Drawdown \_\_\_\_\_ ft. after \_\_\_\_\_ hours \_\_\_\_\_ G.P.M.

USE OF WATER Irrigation Temp. \_\_\_\_\_ °F., 19

SOURCE OF INFORMATION G.R. Record

DRILLER or DIGGER \_\_\_\_\_

### ADDITIONAL DATA:

Log \_\_\_\_\_ Water Level Measurements \_\_\_\_\_ Chemical Analysis \_\_\_\_\_ Aquifer Test \_\_\_\_\_

### REMARKS:

Log: Top soil 0 to 2 ft.  
Clay 2 to 60 ft.  
Sand 60 to 69 ft.

Irrigation of 3.54 acres.