

STATE ENGINEER  
Salem, Oregon

# Well Record

**Colu**

STATE WELL NO. 4N/1W-8N  
COUNTY Columbia  
APPLICATION NO. GR-4051

32914

OWNER: Emma M. Saxton

MAILING ADDRESS:

LOCATION OF WELL: Owner's No. \_\_\_\_\_

CITY AND STATE:

Warren, Oregon


SW  $\frac{1}{4}$  SW  $\frac{1}{4}$  Sec. 8 T. 4 N. S., R. 1 E. W., W.M.

Bearing and distance from section or subdivision corner \_\_\_\_\_

Altitude at well \_\_\_\_\_

TYPE OF WELL: Drilled Date Constructed 1954

Depth drilled 67 Depth cased 67

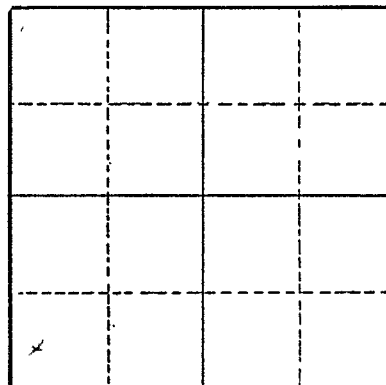

Section 8

### CASING RECORD:

8-inch from 0 to 67 feet

### FINISH:

Unknown

### AQUIFERS:

Unknown

### WATER LEVEL:

10 feet

PUMPING EQUIPMENT: Type Pacific Model JN8 H.P. 3-Jet  
Capacity 50 G.P.M.

### WELL TESTS:

Drawdown \_\_\_\_\_ ft. after \_\_\_\_\_ hours \_\_\_\_\_ G.P.M.

Drawdown \_\_\_\_\_ ft. after \_\_\_\_\_ hours \_\_\_\_\_ G.P.M.

USE OF WATER Group domestic Temp. \_\_\_\_\_ °F., 19 \_\_\_\_\_

SOURCE OF INFORMATION GR-4051

DRILLER or DIGGER F. E. McKnight

### ADDITIONAL DATA:

Log \_\_\_\_\_ Water Level Measurements \_\_\_\_\_ Chemical Analysis \_\_\_\_\_ Aquifer Test \_\_\_\_\_

### REMARKS:



St. Helens, Oregon  
Sept. 5, 1959

State Engineer  
Water Resources Dept.

Dear Sir:

In reply to file # 261, am  
sending additional information  
on the well report section by  
Svend A. Wald.

Lot number (8), in block  
numbered (2) in Golf Club  
addition to the city of St. Helens.  
(recorded in Book 68, page 361.)

Yours truly,

Ed Simons

RECEIVED  
SEP 8 1959  
STATE ENGINEER  
HELENS, OREGON