

STATE ENGINEER
Salem, Oregon

WELL RECORD

STATE WELL NO. 4N/1W-19L(1)
COUNTY Columbia
APPLICATION NO. GR-741

OWNER: Philip L. Hickey


MAILING ADDRESS: Route 1, Box 644

LOCATION OF WELL: Owner's No. 1

CITY AND STATE: Warren, Oregon

NE $\frac{1}{4}$ SW $\frac{1}{4}$ Sec. 19 T. 4 N. X, R. 1 W., W.M.

Bearing and distance from section or subdivision corner 1000' W. & 750' N. of SW Cor. at NW $\frac{1}{4}$ of SE $\frac{1}{4}$, Sec. 19

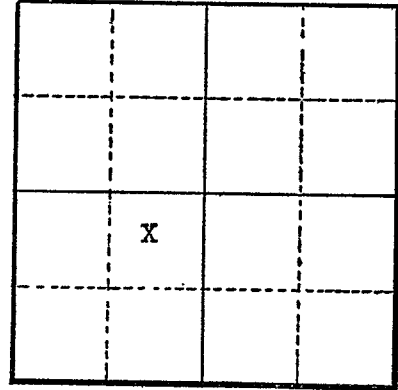

Section 19

Altitude at well 110 ft. Interpolated

TYPE OF WELL: drilled Date Constructed 1950

Depth drilled 436 ft. Depth cased 436 ft.

CASING RECORD:	12 in.	0 to 125 ft.
	10 in.	110 to 152 ft.
	8 in.	150 to 285 ft.
	6 in.	276 to 436 ft.

FINISH:	12 in.	standard perforations	50 to 110 ft.
	10 in.	" "	112 to 150 ft.
	8 in.	" "	
	6 in.	" "	396 to 434 ft.

AQUIFERS:

WATER LEVEL: 20 ft.

PUMPING EQUIPMENT: Type 3 ph. elec. Peerless turbine H.P. 15
Capacity 180 G.P.M.

WELL TESTS:

Drawdown 160 ft. after _____ hours 170 G.P.M.

Drawdown _____ ft. after _____ hours _____ G.P.M.

USE OF WATER Irrigation Temp. _____ °F. _____, 19

SOURCE OF INFORMATION GR-741

DRILLER or DIGGER _____

ADDITIONAL DATA:

Log X Water Level Measurements _____ Chemical Analysis _____ Aquifer Test _____

REMARKS:

