

STATE ENGINEER
Salem, Oregon

COLO Well Record

STATE WELL NO. LN/2W-10
COUNTY Columbia
APPLICATION NO. GR-3135

33913

OWNER: Kenneth Asbury


MAILING ADDRESS: Route 1, Box 442

LOCATION OF WELL: Owner's No. _____

CITY AND STATE: St. Helens, Oregon

N $\frac{1}{2}$ SW $\frac{1}{4}$ SE $\frac{1}{4}$ Sec. 1 T. 4 N. ~~S~~ R. 2 W., W.M.

Bearing and distance from section or subdivision corner $\frac{1}{4}$ mile N. $\frac{3}{8}$ mile W.

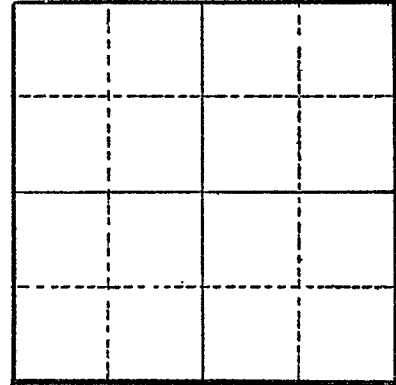

Section _____

Altitude at well _____

TYPE OF WELL: Drilled Date Constructed 1954

Depth drilled 270' Depth cased 207'

CASING RECORD:

6"

FINISH:

AQUIFERS:

clay, rock

WATER LEVEL:

150'

PUMPING EQUIPMENT: Type Sumo-Submersible

H.P. 7 $\frac{1}{2}$

Capacity 75 G.P.M.

WELL TESTS:

Drawdown 90 ft. after _____ hours pumping 42 G.P.M.

Drawdown _____ ft. after _____ hours _____ G.P.M.

USE OF WATER Irrigation Temp. _____ °F. _____, 19____

SOURCE OF INFORMATION GR-2940

DRILLER or DIGGER Guy Lutteral St. Helens, Oregon

ADDITIONAL DATA:

Log Water Level Measurements _____ Chemical Analysis _____ Aquifer Test _____

REMARKS:

Clay 207 207
Solid Rock 63 270