

STATE ENGINEER
Salem, Oregon

COLU
31097

Well Record

GR- 1752

STATE WELL NO. 4N/2W-13J
COUNTY Columbia
APPLICATION NO. GR- 1811

OWNER: John C. & Clarence Johnson


MAILING ADDRESS: Rt. 1, Box 35

LOCATION OF WELL: Owner's No. _____

CITY AND STATE: Warren, Oregon

NE 1/4 SE 1/4 Sec. 13 T. 4 N. S R. 2 E. W., W.M.

Bearing and distance from section or subdivision corner 406' S. & 576' W. from Pt. cor. Sec. 13.

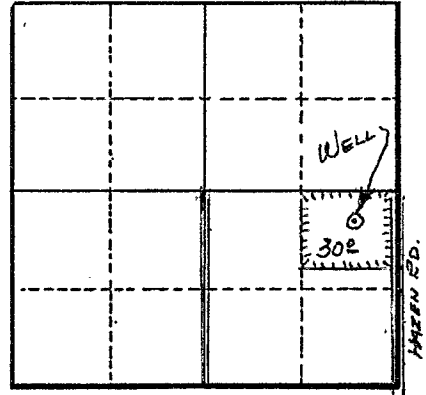

Section 13

Altitude at well _____

TYPE OF WELL: Drilled Date Constructed 1950

Depth drilled 205' Depth cased ?

CASING RECORD:

8"

FINISH:

AQUIFERS:

WATER LEVEL:

PUMPING EQUIPMENT: Type F. M. H.P. 10
Capacity 150 G.P.M.

WELL TESTS:

Drawdown 100 ft. after _____ hours 150 G.P.M.
Drawdown _____ ft. after _____ hours _____ G.P.M.

USE OF WATER Irrigation Temp. _____ °F. _____, 19.

SOURCE OF INFORMATION GR Record

DRILLER or DIGGER _____

ADDITIONAL DATA:

Log N.A. Water Level Measurements _____ Chemical Analysis _____ Aquifer Test _____

REMARKS:

Irrigation of 30 acres.