

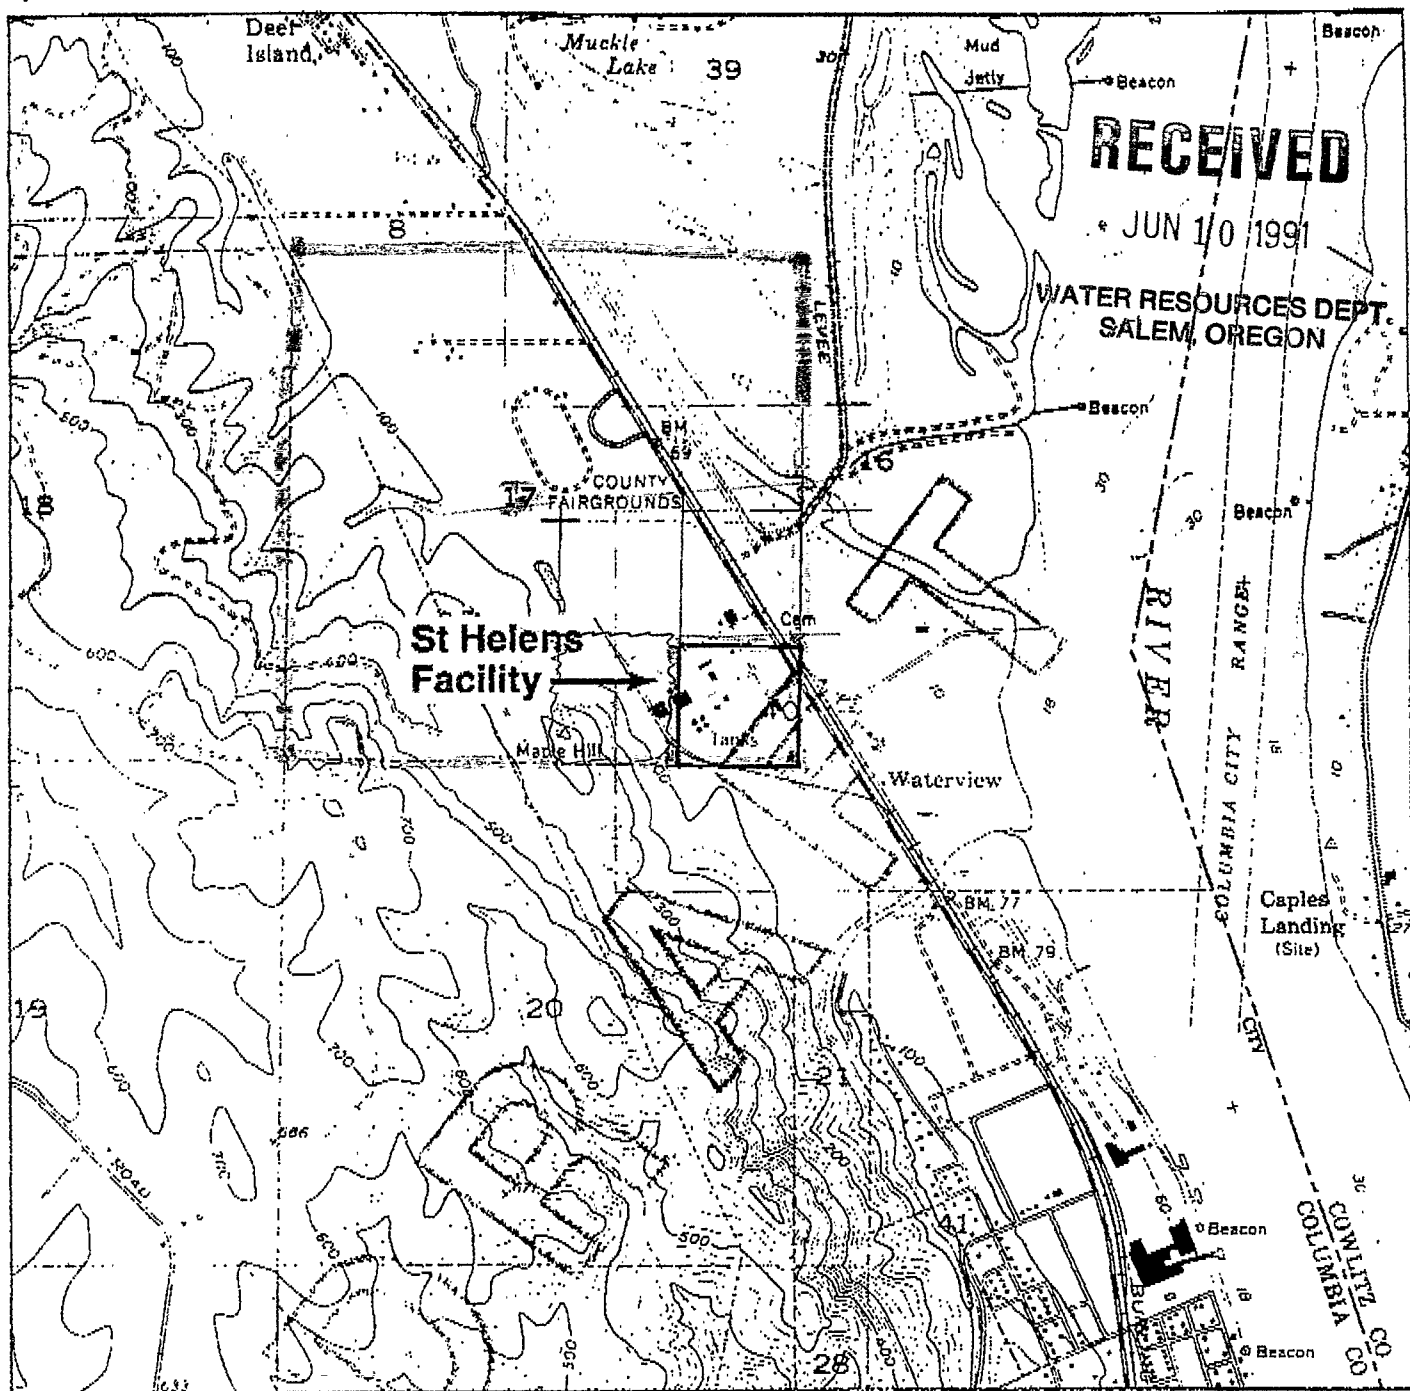


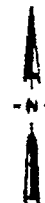

Source: U.S.G.S. 15' Quadrangle of Deer Island, Oregon-Washington

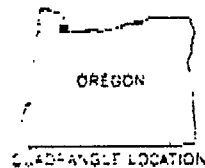

0 2000
feet


Project No. 91C0055A	Chevron Site Assessment	LOCATION MAP ST HELENS FACILITY	Figure 5-1
Woodward-Clyde Consultants			

Post-It™ brand fax transmittal memo 7671		# of pages > 1
To DERRY	From KELLY TEAGUE	
Co. LAYNE ENV.	Co.	
Dept.	Phone # 543-7933	
Fax # 1-926-0714	Fax #	

RECEIVED

JUN 10 1991

WATER RESOURCES DEPT.
SALEM, OREGON

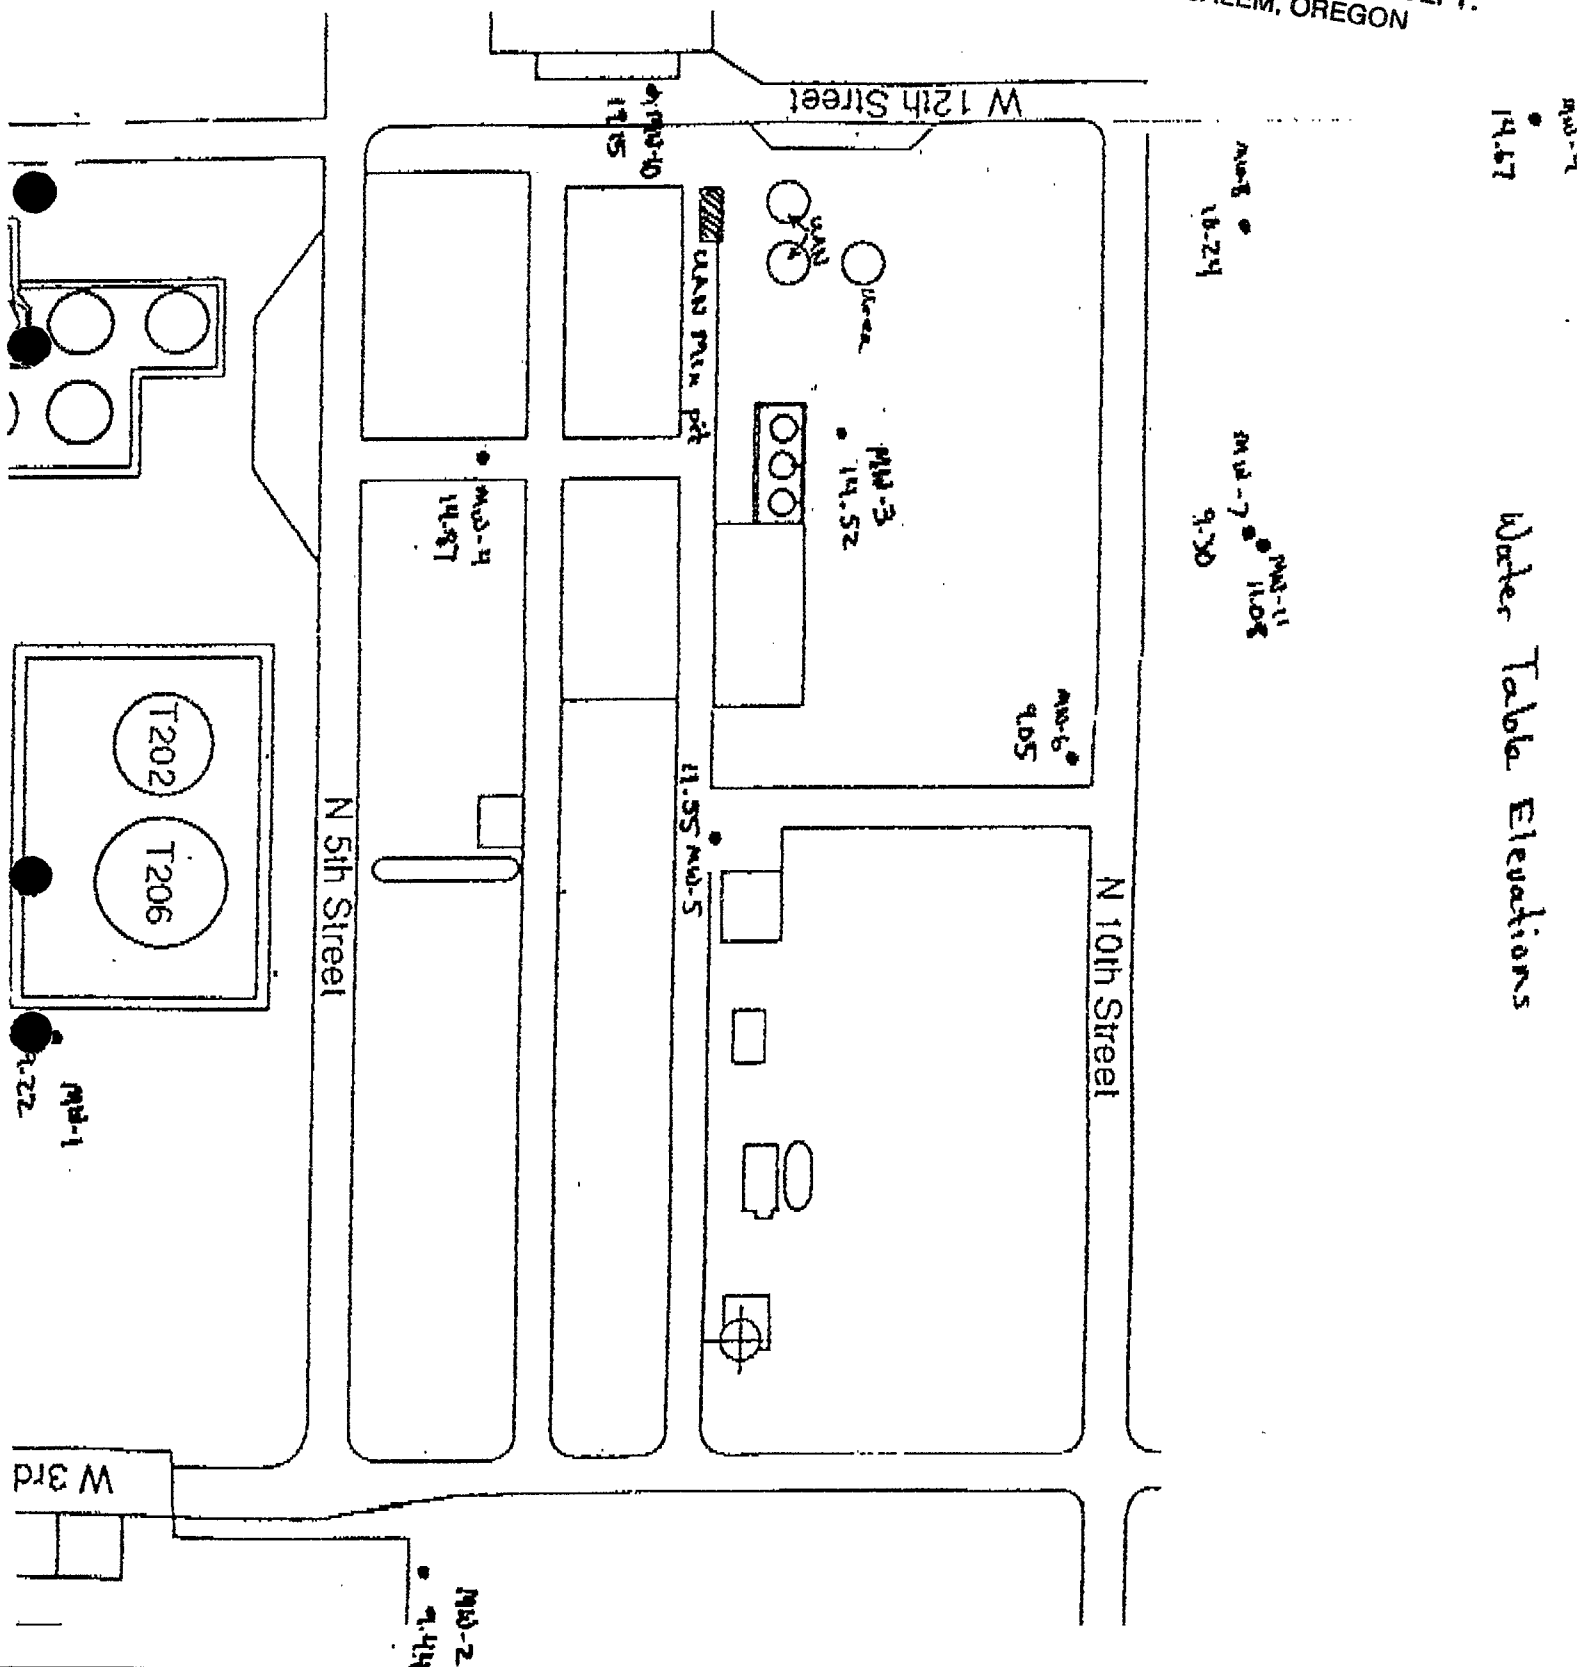

Water Table Elevations



Oregon Water Resources Department
725 Summer Street NE, Suite A
Salem Oregon 97301
(503) 986-0900
www.oregon.gov/owrd

Application for Well ID Number

Do not complete if the well already has a Well Identification Number.

RECEIVED

AUG 15 2023

I. OWNER INFORMATION

OWRD

Current Owner Name (please print): Dyno Nobel, Inc.

Mailing Address: 63149 Columbia River Hwy.

City, State, Zip: Deer Island, Oregon 97054

Mail Well ID to: ☒ SAME AS ABOVE ☒ In Care Of (C/O)

Name & Address: Fran Erickson 63149 Columbia River Hwy

City, State, Zip: Deer Island, Oregon 97054

II. WELL LOCATION INFORMATION (Please fill out as completely as possible)

Township: 5 (North / South) Range: 1 (East / West) Section: 17 SW 1/4 of the SE 1/4

Tax Lot (usually last 3-5 numbers of Tax Map #): 203 County Columbia

GPS Coordinates: 45.91275519 -122.8294509

Street Address of Well, City: 63149 Columbia River Hwy, Deer Island

If the property had a different street address in the past: Site Specific Well ID = MW-6

III. GENERAL WELL INFORMATION (Please fill out as completely as possible, AND attach copy of Well Report, if available)

Use of Well (domestic, irrigation, commercial, industrial, monitoring): Monitoring

Date Well Constructed (or property built): 5/10/1991 Total Well Depth: 83.7 ft Casing Diameter: 4 Inches

Owner at time the well was constructed (if known): Chevron Chemical Co. Well Report # (if known): COLU 374

Other Information: NA

SUBMITTED BY (please print): Fran Erickson

PHONE: 503-366-8902

EMAIL &/or FAX: Fran.Erickson@Am.DynoNobel.com

To send the completed application, you may MAIL it to: Oregon Water Resources Dept. 725 Summer St NE, Suite A, Salem, Oregon 97301.
Or EMAIL the completed PDF form to: Ladeena.K.Ashley@water.oregon.gov, or FAX it to: (503) 986-0902.

For Official Use Only by the Oregon Water Resources Department:

Received Date:

8-15-2023

Well Report Number:

COLU 374

Well Identification #:

L-152815