

**STATE OF OREGON
MONITORING WELL REPORT**
(as required by ORS 537.765 & OAR 690-240-095)

Start Card # 28636


(1) OWNER/PROJECT: WELL NO. MW-7
Name Chevron Chemical Company
Address 63149 Columbia River Hwy
City ST Helens State OR Zip 97051

(2) TYPE OF WORK:
☒ New construction ☐ Repair ☐ Recondition
☐ Conversion ☐ Deepening ☐ Abandonment

(3) DRILLING METHOD
☐ Rotary Air ☐ Rotary Mud ☐ Cable
☐ Hollow Stem Auger ☒ Other Small Wall Percussion hammer

(4) BORE HOLE CONSTRUCTION

Standards Yes No
☐ ☒ Depth of completed well 89 ft.

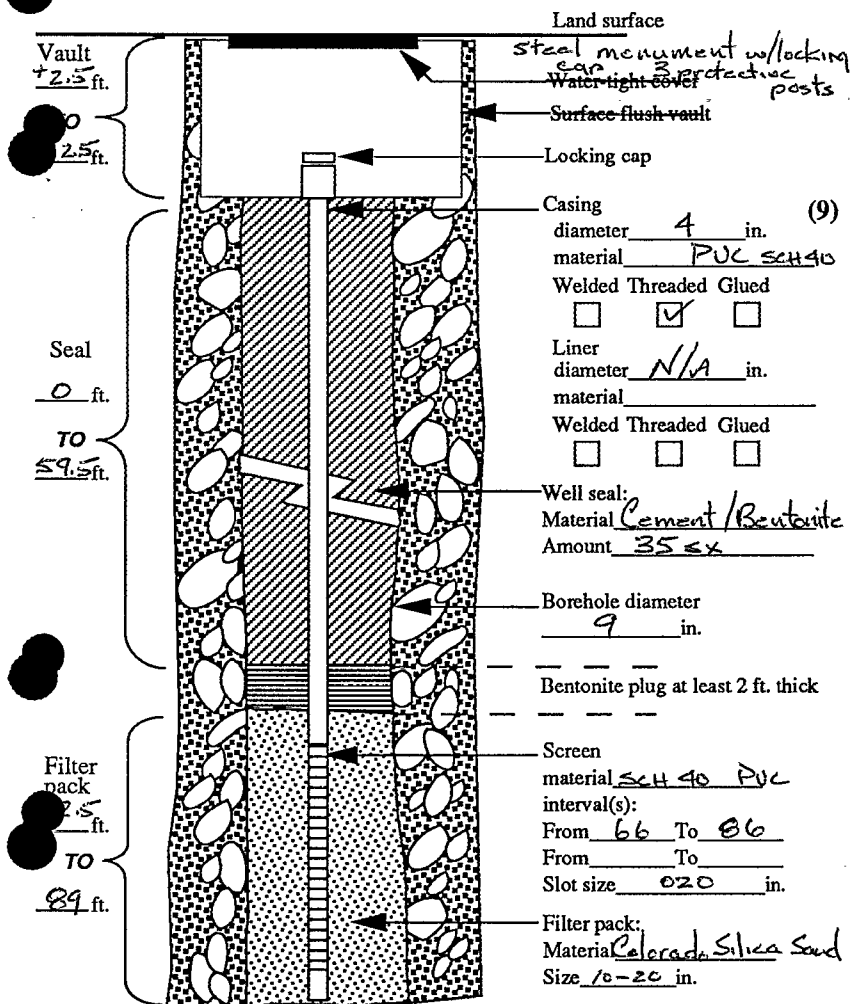

(5) WELL TEST:

☐ Pump ☒ Bailer ☐ Air ☐ Flowing Artesian
Permeability _____ Yield _____ GPM
Conductivity _____ PH _____
Temperature of water 11.8 °F Depth artesian flow found _____ ft.
Was water analysis done? ☐ Yes ☐ No
By whom? _____
Depth of strata to be analyzed. From _____ ft. to _____ ft.
Remarks: _____

Name of supervising Geologist/Engineer CARL ERICKSON

(6) LOCATION OF WELL By legal description

Well Location: County Columbia
Township 5 (N or S) Range 1 (E or W) Section 17
1. SW 1/4 of SE 1/4 of above section.
2. Street address of well location 63149 Columbia River Hwy
ST Helens OR 97051
3. Tax lot number of well location 2-08511700060203
4. ATTACH MAP WITH LOCATION IDENTIFIED.

(7) STATIC WATER LEVEL:

68.5 Ft. below land surface. Date 5-11-91
Artesian Pressure _____ lb/sq. in. Date _____

(8) WATER BEARING ZONES:

Depth at which water was first found No water to surface while dry

From	To	Est. Flow Rate	SWL

(9) WELL LOG:

Ground elevation 77 to MP

Material	From	To	SWL
Soil, silty sandy w/ gravel, reddish brown	0	4	
Coarse, cobbly, sandy silty gravel, well graded, wet to moist greyish-brown	4	66	
Gravelly, coarse sand greyish-brown	66	69	
Coarse silty, sandy gravel, wet, greyish-brown			

RECEIVED
JUN 10 1991
WATER RESOURCES DEPT.
SALEM, OREGON

Date started 5-10-91 Completed 5-11-91

(unbonded) Monitor Well Constructor Certification:

I certify that the work I performed on the construction, alteration, or abandonment of this well is in compliance with Oregon well construction standards. Materials used and information reported above are true to the best knowledge and belief.

Signed [Signature] MWC Number 10063
Date 6-5-91

(bonded) Monitor Well Constructor Certification:

I accept responsibility for the construction, alteration, or abandonment work performed on this well during the construction dates reported above. All work performed during this time is in compliance with Oregon well construction standards. This report is true to the best of my knowledge and belief.

Signed [Signature] MWC Number 10093
Date 6/6/91



Oregon Water Resources Department
725 Summer Street NE, Suite A
Salem Oregon 97301
(503) 986-0900
www.oregon.gov/owrd

Application for Well ID Number

Do not complete if the well already has a Well Identification Number.

RECEIVED

AUG 15 2023

I. OWNER INFORMATION

OWRD

Current Owner Name (please print): Dyno Nobel, Inc.

Mailing Address: 63149 Columbia River Hwy.

City, State, Zip: Deer Island, Oregon 97054

Mail Well ID to: ☒ SAME AS ABOVE ☒ In Care Of (C/O)

Name & Address: Fran Erickson 63149 Columbia River Hwy

City, State, Zip: Deer Island, Oregon 97054

II. WELL LOCATION INFORMATION (Please fill out as completely as possible)

Township: 5 (North / South) Range: 1 (East / West) Section: 17 SW 1/4 of the SE 1/4

Tax Lot (usually last 3-5 numbers of Tax Map #): 203 County Columbia

GPS Coordinates: 45.91283903 -122.8300557

Street Address of Well, City: 63201 Columbia River Highway, Deer Island

If the property had a different street address in the past: Site Specific Well ID = MW-7

III. GENERAL WELL INFORMATION (Please fill out as completely as possible, AND attach copy of Well Report, if available)

Use of Well (domestic, irrigation, commercial, industrial, monitoring): Industrial

Date Well Constructed (or property built): 5/11/1991 Total Well Depth: 86.9 ft Casing Diameter: 4 Inches

Owner at time the well was constructed (if known): Chevron Chemical Co. Well Report # (if known): COLU 375

Other Information: NA

SUBMITTED BY (please print): Fran Erickson

PHONE: 503-366-8902

EMAIL &/or FAX: Fran.Erickson@Am.DynoNobel.com

To send the completed application, you may MAIL it to: Oregon Water Resources Dept. 725 Summer St NE, Suite A, Salem, Oregon 97301.
Or EMAIL the completed PDF form to: Ladeena.K.Ashley@water.oregon.gov, or FAX it to: (503) 986-0902.

For Official Use Only by the Oregon Water Resources Department:

Received Date:

8-15-2023

Well Report Number:

COLU 375

Well Identification #:

L-152816