

STATE ENGINEER  
Salem, Oregon

**COLUM**  
3751

# Well Record

STATE WELL NO. 4N/2W-36P  
COUNTY COLUMBIA  
APPLICATION NO. GR-1952

OWNER: Clark W. Sherman


MAILING ADDRESS:

LOCATION OF WELL: Owner's No. \_\_\_\_\_

CITY AND STATE: Scappoose, Oregon

SE 1/4 SW 1/4 Sec. 36 T. 4 N. R. 2 W., W.M.

Bearing and distance from section or subdivision corner about 1400' E of Stone Monument at SW cor  
Cloniger DLC

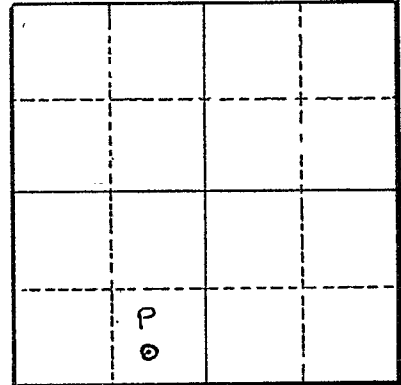

Altitude at well \_\_\_\_\_

TYPE OF WELL: Drilled Date Constructed 1938

Depth drilled 393' Depth cased 393'

Section 36

**CASING RECORD:**

- 10-inch
- 8-inch

**FINISH:**

**AQUIFERS:**

**WATER LEVEL:**

125'

PUMPING EQUIPMENT: Type Deming Turbine Fig. 4700-8 H.P. 25  
Capacity 235 G.P.M.

**WELL TESTS:**

Drawdown 40 ft. after \_\_\_\_\_ hours 200 G.P.M.  
Drawdown \_\_\_\_\_ ft. after \_\_\_\_\_ hours \_\_\_\_\_ G.P.M.

USE OF WATER Irrigation Temp. \_\_\_\_\_ °F., 19.

SOURCE OF INFORMATION GR-3868

DRILLER or DIGGER A. M. Janssen Drilling Co.

**ADDITIONAL DATA:**

Log NA Water Level Measurements \_\_\_\_\_ Chemical Analysis \_\_\_\_\_ Aquifer Test \_\_\_\_\_

**REMARKS:**