



Oregon Water Resources Department
725 Summer Street NE, Suite A
Salem Oregon 97301
(503) 986-0900
www.wrd.state.or.us

Application for Well ID Number

RECEIVED BY OWRD

Do not complete if the well already has a Well I.D Number.

AUG 21 2013

I. OWNER INFORMATION

SALEM, OR

Current Owner Name (please print): MICHAEL & LEZLIE COOK
Mailing Address: P.O. Box 243 VERNONIA
City: VERNONIA State: OREGON Zip: 97064
Mailing Address (to send Well I.D.): 58215 TIMBER RD
City: VERNONIA State: OREGON Zip: 97064

II. WELL INFORMATION (Do not complete this section if the well report is attached.)

Township: 4 (North/South) Range: 5 (East/West) Section: 12
Tax Lot: _____ County: COLUMBIA 1/4 _____ 1/4
Street Address of Well: 58215 TIMBER RD City: VERNONIA
Owner at time the well was constructed, (if known): MICHAEL COOK
If the property had a different street address in the past: _____

III. GENERAL WELL INFORMATION (Do not complete this section if the well report is attached)

Use of Well (domestic, irrigation, commercial, industrial, monitoring): DOMESTIC
Date Well Constructed: 9/15/04 Total Well Depth: 24' Casing Diameter: 4'
Other Information: _____

SUBMITTED BY (please print): MICHAEL A COOK PO Box 243 Vernonia OR
PHONE: 503-519-1509 FAX: — 97064

Send application to Oregon Water Resources Department; 725 Summer St NE, Suite A; Salem, Oregon 97301-1266; fax (503) 986-0902. Applications are processed and Well I.D. Numbers are mailed every Wednesday.

For Official Use Only by the Oregon Water Resources Department:

Received Date:

8-21-13

Well Log Number:

COLU 54684

Well Identification #:

L-112346


**Professional
Laboratory
Services**

13035 SW Pacific Hwy.
Tigard, OR 97223
Tel.: (503) 639-9311 Fax: (503) 684-1588

Reported: 06/20/2013
Sampled: 06/17/13 19:10
Received: 06/18/13
Sampled By:
Work Order: 3169008

C Hillsboro Pump Service
L Attn: -
I PO Box 890
E Cornelius OR, 97113
N Phone: (503) 357-4217
T

Project: Mike Cook
PO #: -
Project #: N/A
Sampling Location: 58715 Timber Rd
Sample Matrix: Water

Lab Number	Sample Name						Secondary	Analysis
3169008-01	Pumphouse						Standard*	Date/ Time
Metals (Total)	Method	Units	Result	MRL	EPA MCL			
† Arsenic	EPA 200.9	mg/L	ND	0.003	0.01			06/20/13 12:49
Wet Chemistry	Method	Units	Result	MRL	EPA MCL		Secondary	Analysis
† Nitrate as N	SM4500-NO3 D	mg/L	ND	0.5	10		Standard*	Date/ Time
								06/18/13 14:45

Lab Number	Sample Name	Sampled: 6/17/13 19:10		
3169008-01	Pumphouse			
Microbiological Analysis	Method	Result	Analysis Date/ Time	
† Total Coliforms	SM 9223B (collert-18) 21st Ed.	Absent	6/18/13 14:11	
† E. coli	SM 9223B (collert-18) 21st Ed.	Absent	6/18/13 14:11	

ND = None detected MRL = Minimum Reporting Limit MCL = Maximum Contamination Limit
† This analysis conforms to NELAC standards.


RECEIVED BY OWRD


AUG 21 2013

SALEM, OR

Approved by:

Scott Dickman
Lab Director

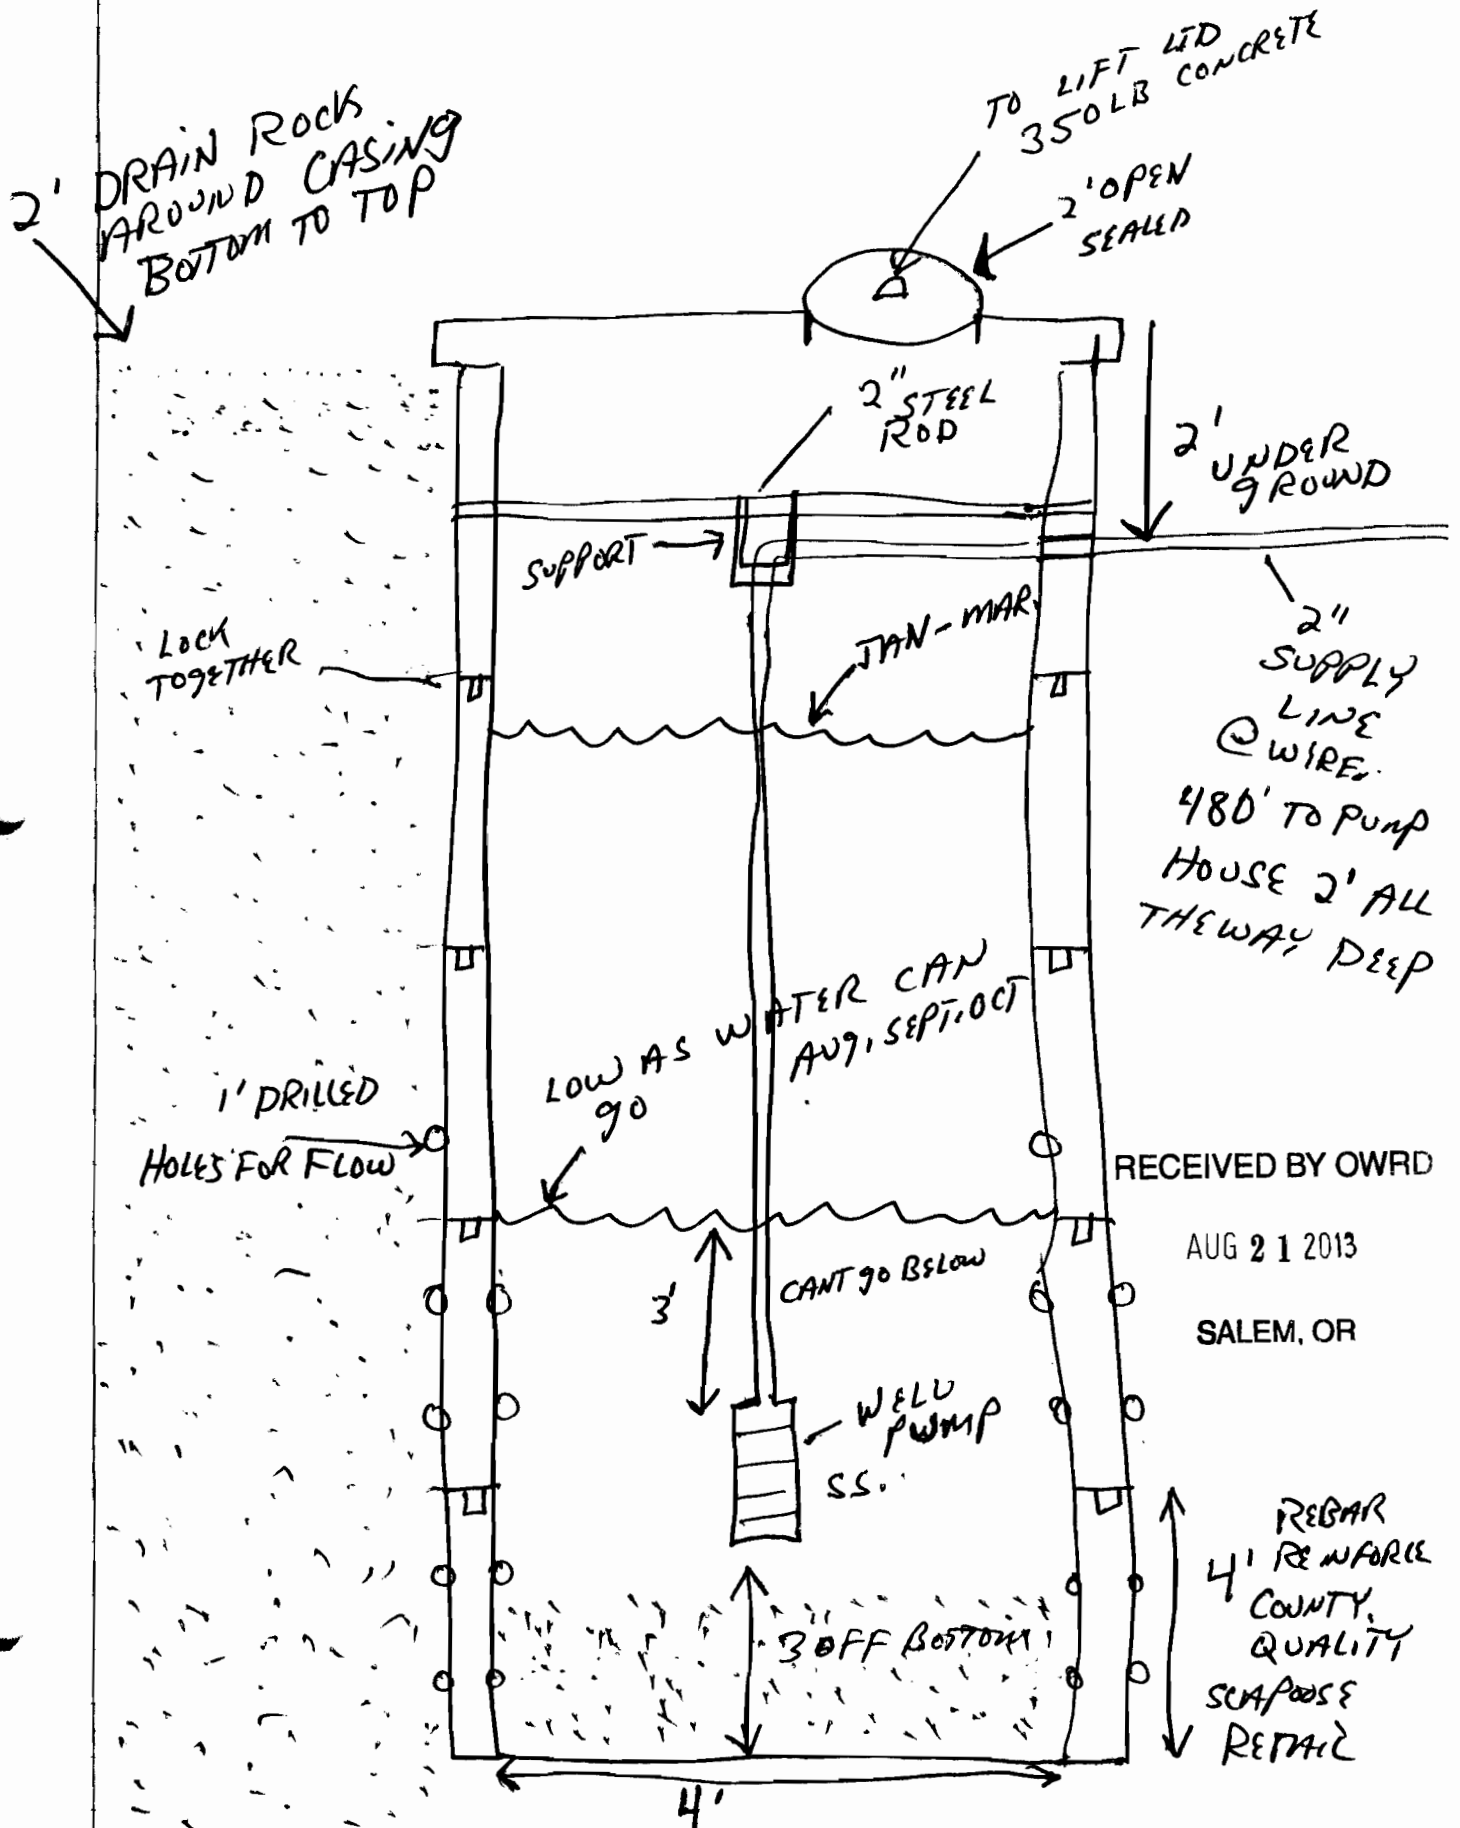

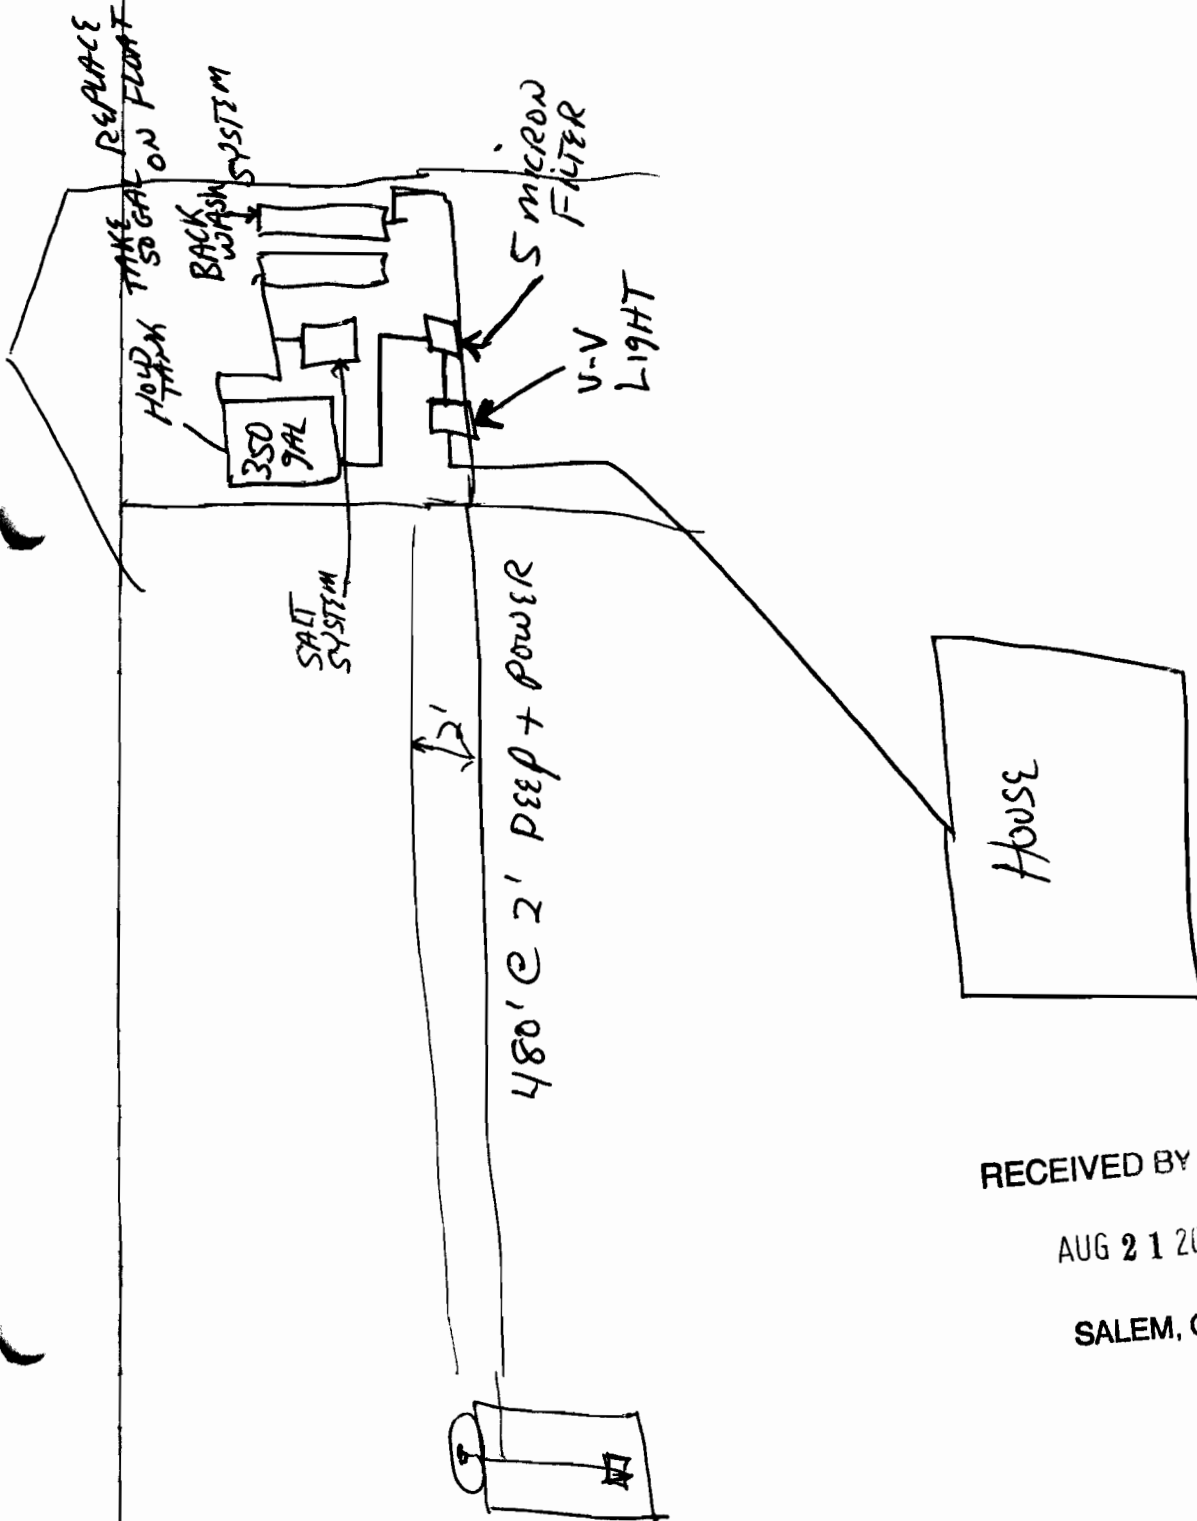

RECEIVED BY OWRD

AUG 21 2013

SALEM, OR