


WATER SUPPLY WELL REPORT - Map with location identified must be attached and shall include an approximate scale and north arrow

COLU 56316

3/24/2026

Map of Hole

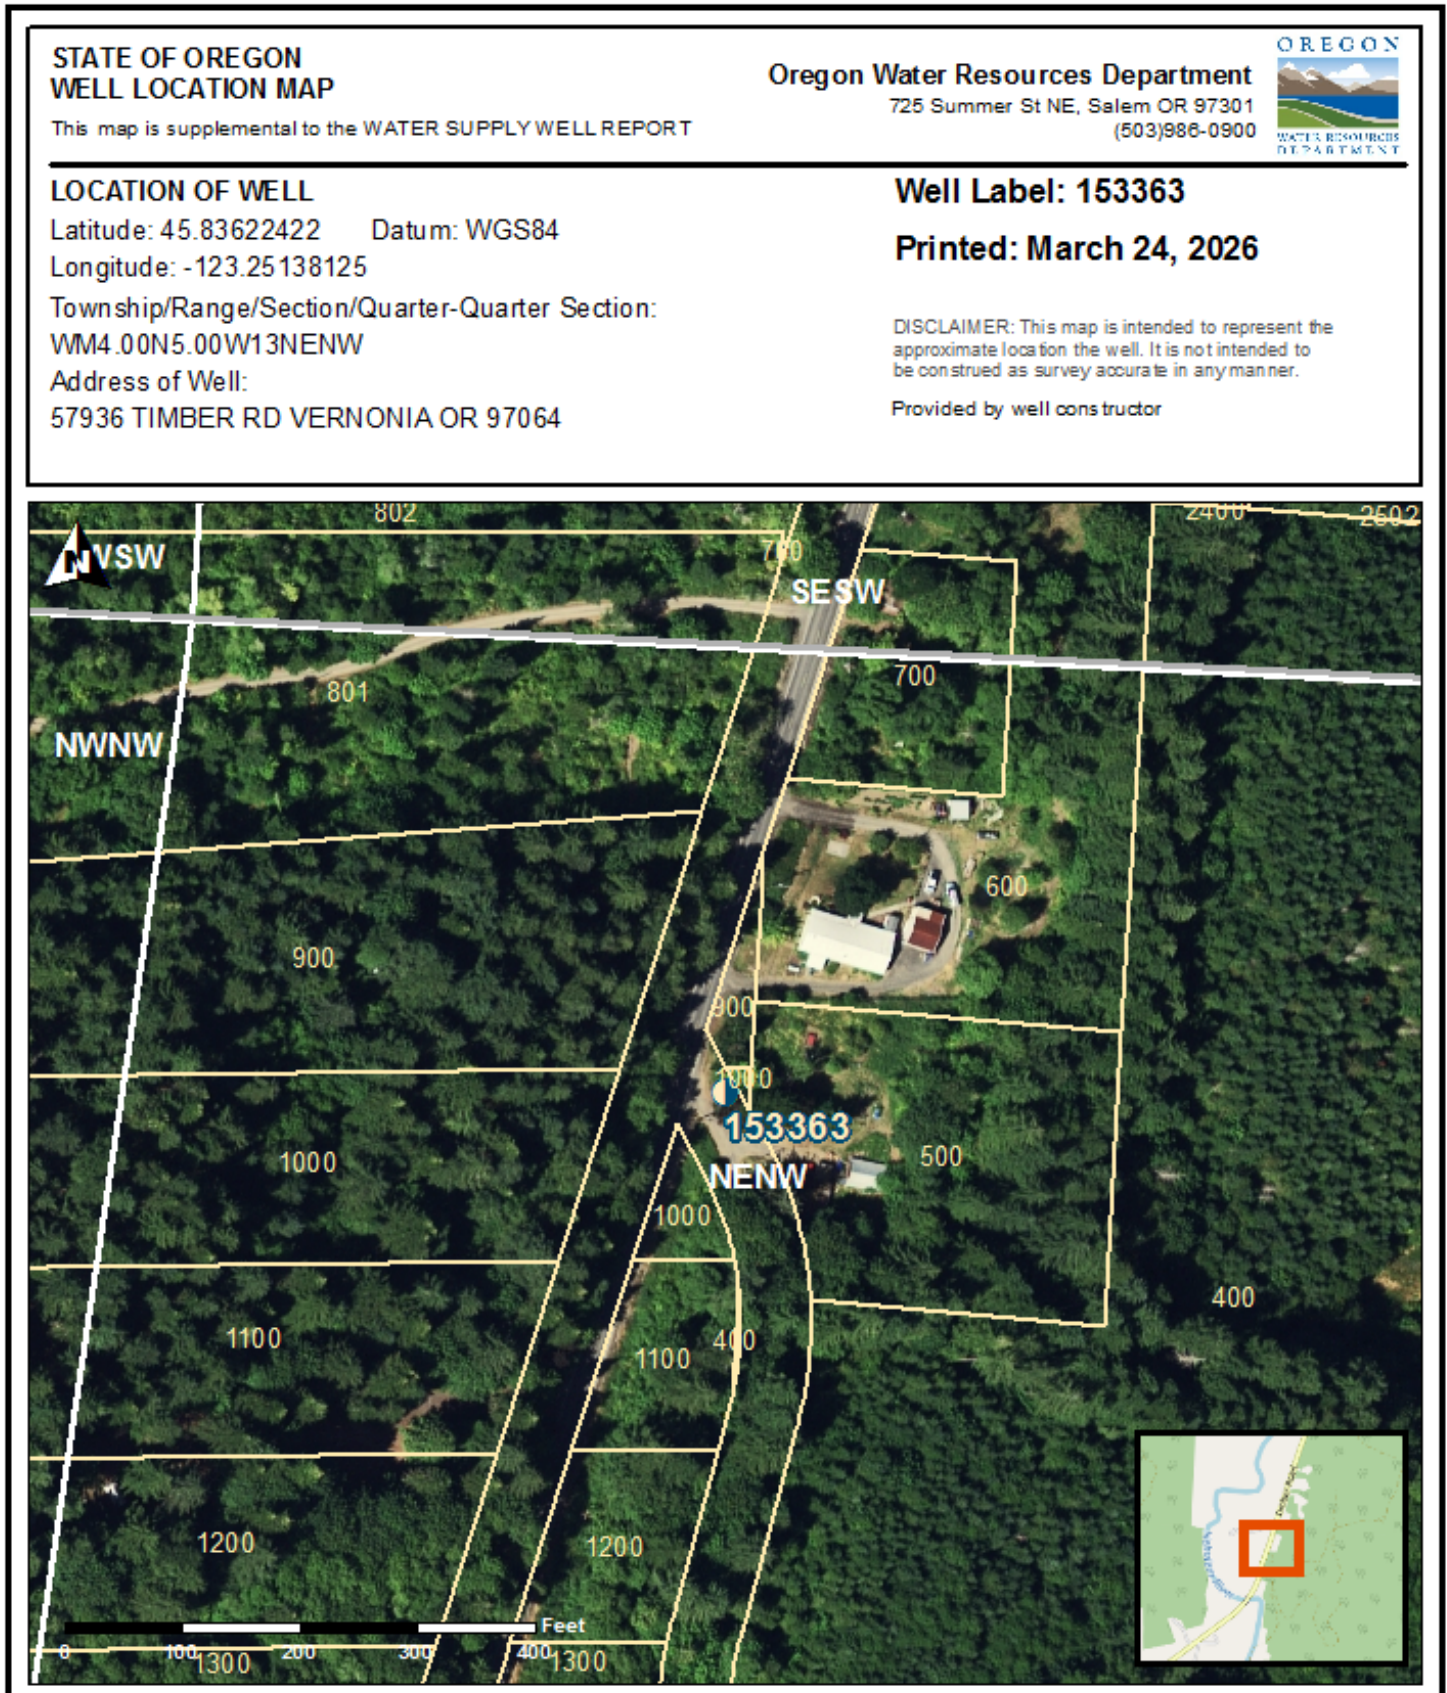

3/24/2026

Map of Hole

