


5N/1W/17 cd
Start Card # 38286

Well Location County Oregon Columbia
Township T5N (N or S) Range R1 (E or W) Section 17
1. SE 1/4 of SW 1/4 of above section.
2. Street address of well location 63149 Columbia River Hwy St Helens OREGON 97051
3. Tax lot number of well location 2-08511700000203
4. ATTACH MAP WITH LOCATION IDENTIFIED.

71 Ft. below land surface. Date 2-27-91
Artesian Pressure _____ lb/sq. in. Date _____

Depth at which water was first found _____

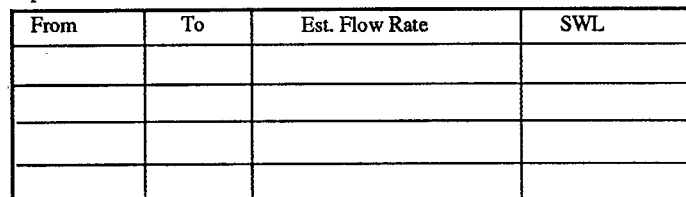

Ground elevation _____

[illegible]

Date started 2-26-93 Completed 2-27-93

MWC Number 10093
Date 3/1/93


RECEIVED

MAR - 5 1993

FEB 17 1993 11:34AM WOODWARD-CLYDE SEATTLE

WATER RESOURCES DEPT
SALEM OREGON

P.2

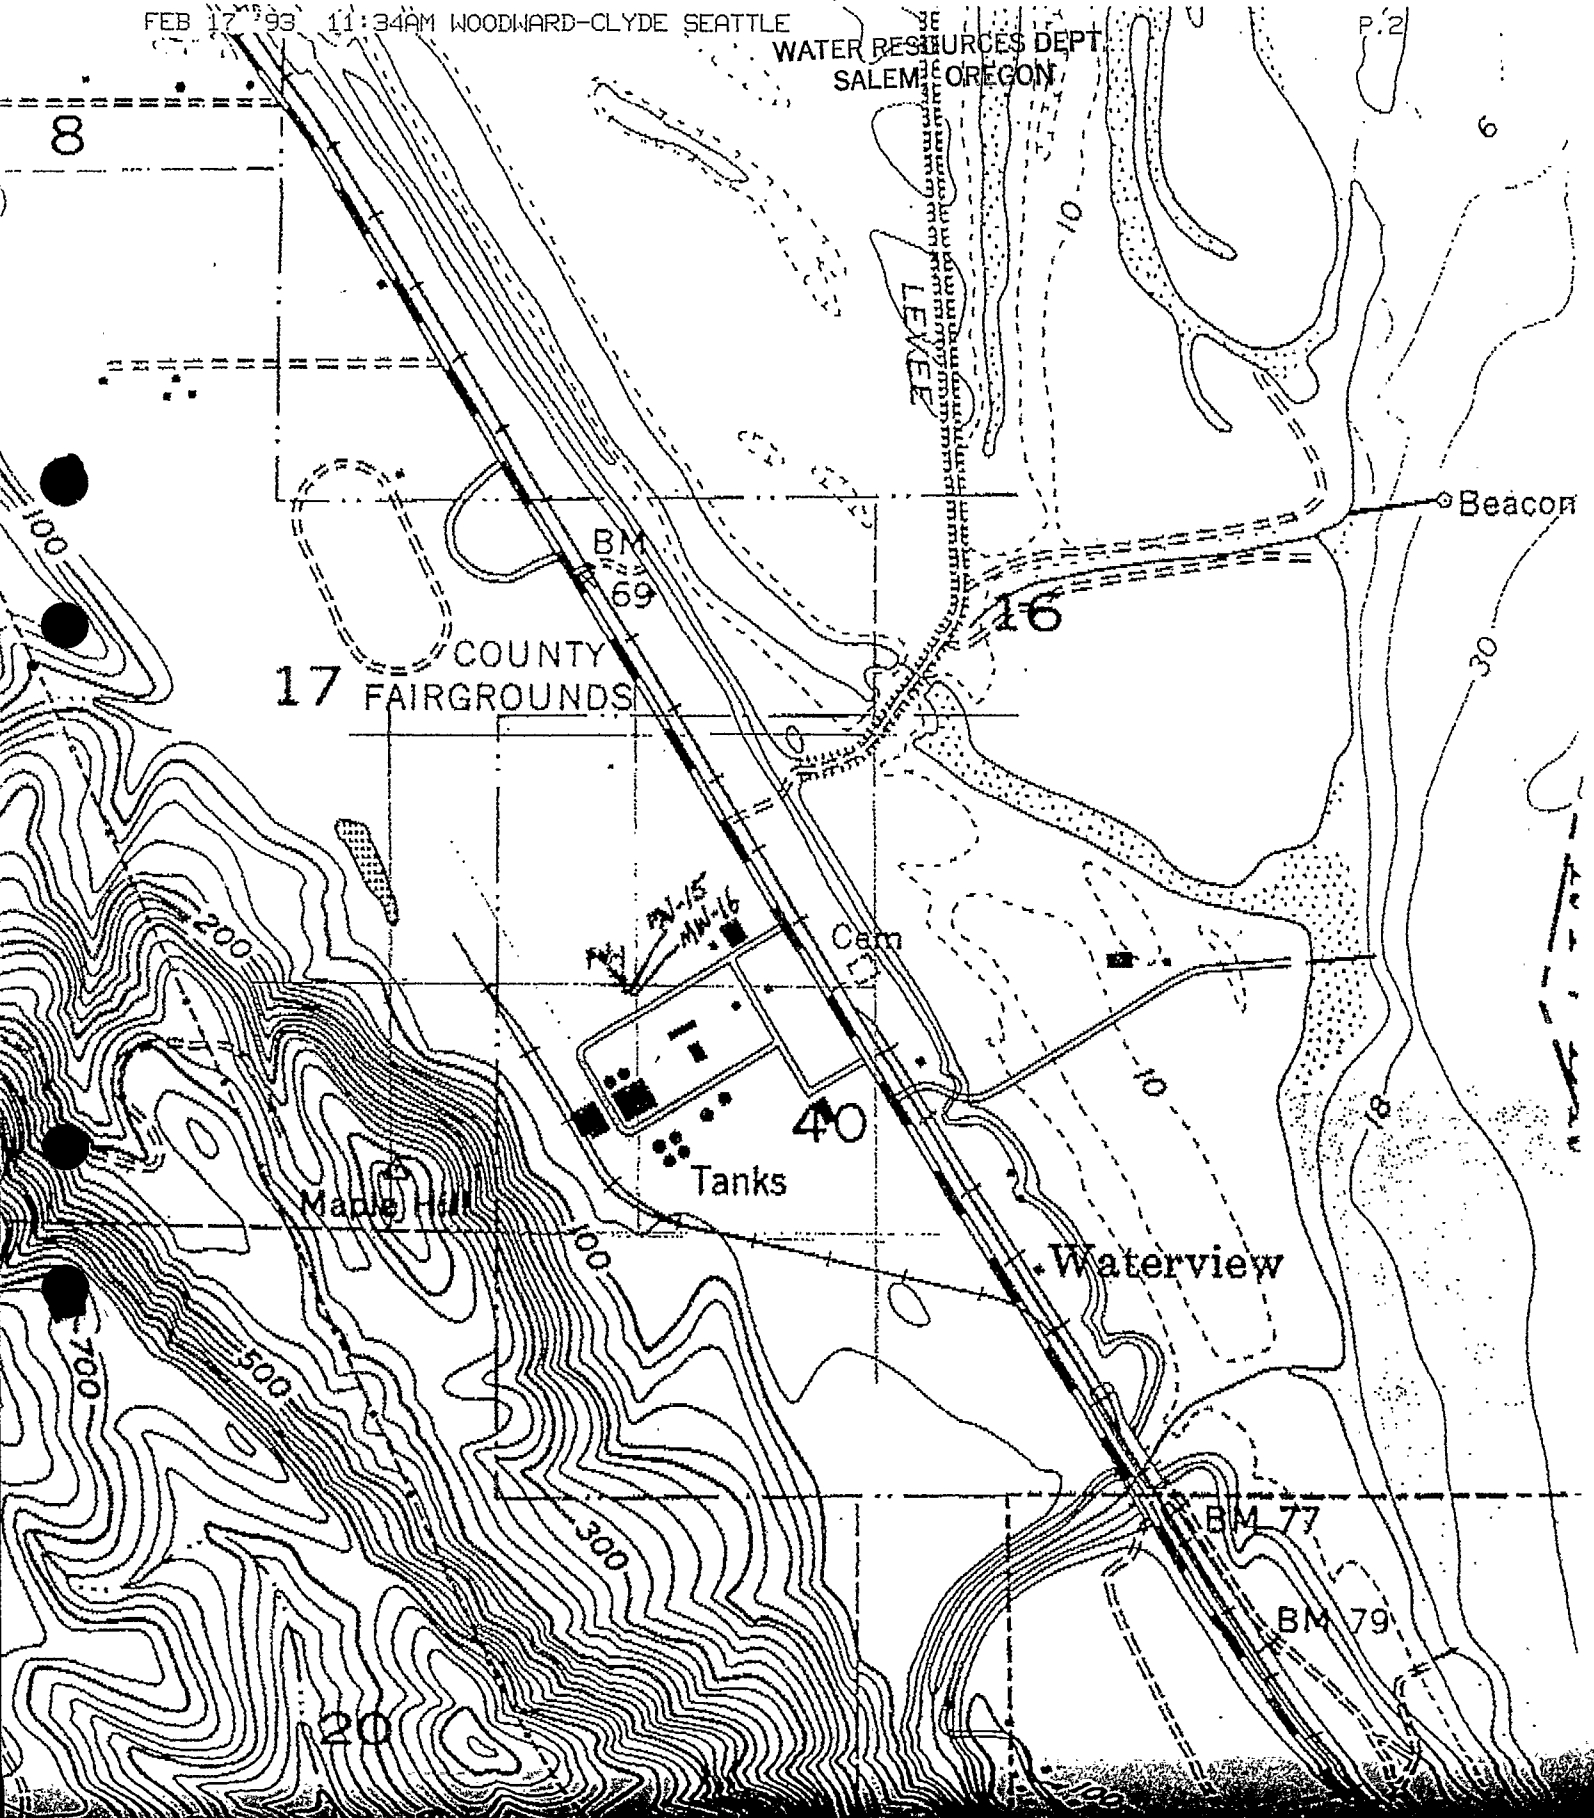



Oregon Water Resources Department
725 Summer Street NE, Suite A
Salem Oregon 97301
(503) 986-0900
www.oregon.gov/owrd

Application for Well ID Number

Do not complete if the well already has a Well Identification Number.

RECEIVED

AUG 15 2023

I. OWNER INFORMATION

OWRD

Current Owner Name (please print): Dyno Nobel, Inc.

Mailing Address: 63149 Columbia River Hwy.

City, State, Zip: Deer Island, Oregon 97054

Mail Well ID to: ☒ SAME AS ABOVE ☒ In Care Of (C/O)

Name & Address: Fran Erickson 63149 Columbia River Hwy

City, State, Zip: Deer Island, Oregon 97054

II. WELL LOCATION INFORMATION (Please fill out as completely as possible)

Township: 5 (North / South) Range: 1 (East / West) Section: 17 SW 1/4 of the SE 1/4

Tax Lot (usually last 3-5 numbers of Tax Map #): 203 County Columbia

GPS Coordinates: 45.91315564 -122.8298644

Street Address of Well, City: 63201 Columbia River Highway, Deer Island

If the property had a different street address in the past: Site Specific Well ID = MW-15

III. GENERAL WELL INFORMATION (Please fill out as completely as possible, AND attach copy of Well Report, if available)

Use of Well (domestic, irrigation, commercial, industrial, monitoring): Monitoring

Date Well Constructed (or property built): 2/27/1993 Total Well Depth: 90.3 ft Casing Diameter: 4 Inches

Owner at time the well was constructed (if known): Chevron Chemical Co. Well Report # (if known): COLU 616

Other Information: NA

SUBMITTED BY (please print): Fran Erickson

PHONE: 503-366-8902

EMAIL &/or FAX: Fran.Erickson@Am.DynoNobel.com

To send the completed application, you may MAIL it to: Oregon Water Resources Dept. 725 Summer St NE, Suite A, Salem, Oregon 97301.
Or EMAIL the completed PDF form to: Ladeena.K.Ashley@water.oregon.gov, or FAX it to: (503) 986-0902.

For Official Use Only by the Oregon Water Resources Department:

Received Date:

8-15-2023

Well Report Number:

COLU 616

Well Identification #:

L-152823