

38285

38285


OREGON
Well Location: County Columbia
Township TSN (N or S) Range 3-1 (E of W) Section 17
1. SE 1/4 of SW 1/4 of above section.
2. Street address of well location 63149 Columbia
Riverway St Helena OR 97051
3. Tax lot number of well location 2-0851700000203
4. ATTACH MAP WITH LOCATION IDENTIFIED.

71 Ft. below land surface. Date 2-26-93
Artesian Pressure lb/sq. in. Date _____

☐ Rotary Air ☐ Rotary Mud ☐ Cable
☐ Hollow Stem Auger ☒ Other *Auger / well / Percussion*

Special Standards ☒ Yes ☐ No Depth of completed well 90 ft.

Depth at which water was first found 80

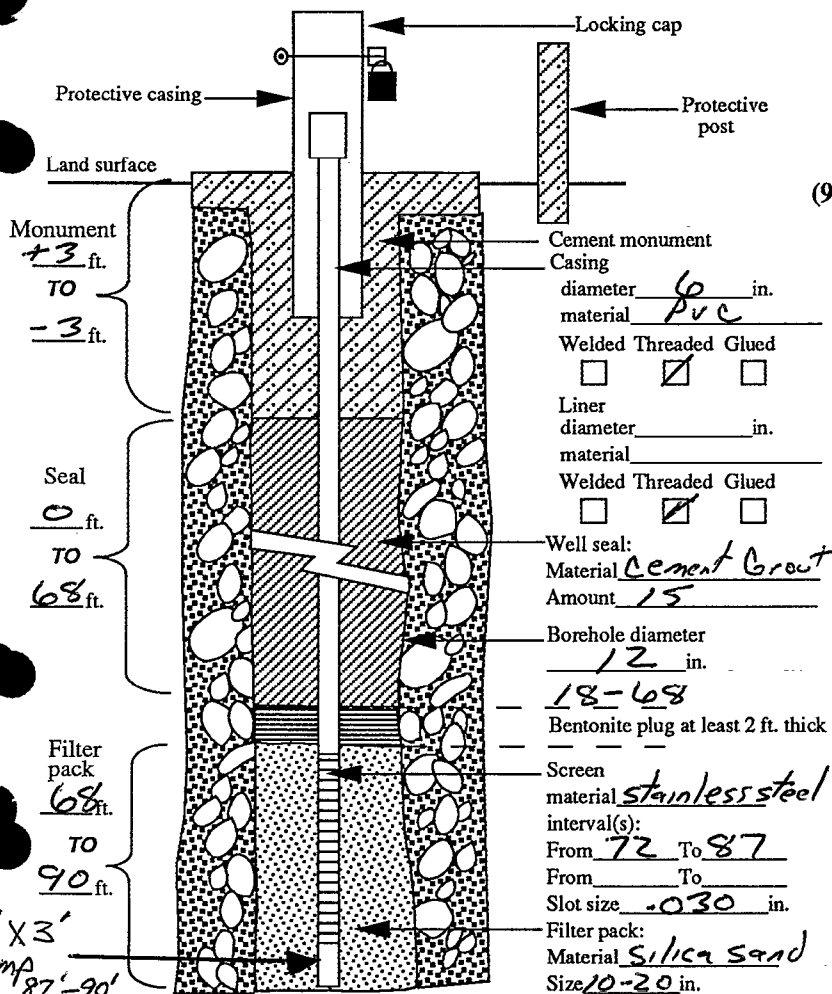

Ground elevation_____

From	To	Est. Flow Rate	SWL

Material	From	To	SWL
Reddish Brown silty sand damp	0	5	71
Brown Fine to med Grain silty sand with cobbles	5	81	
Brown silty coarse sand	81	86	
Brown very silty Fine to medium sand	86	90	
	RECEIVED		
	MAR 26 1993		
	WATER RESOURCES DEPT SALEM, OREGON		

Date started 2-24-93 Completed 2-26-93

Name of supervising Geologist/Engineer Carl Erickson
MCS.

MWC Number 10093
Date 3/1/93

RECEIVED


MAR - 5 1993

FEB 17 1993 11:34AM WOODWARD-CLYDE SEATTLE

WATER RESOURCES DEPT.
SALEM, OREGON

RECEIVED
MAR 26 1993

WATER RESOURCES DEPT.
SALEM, OREGON

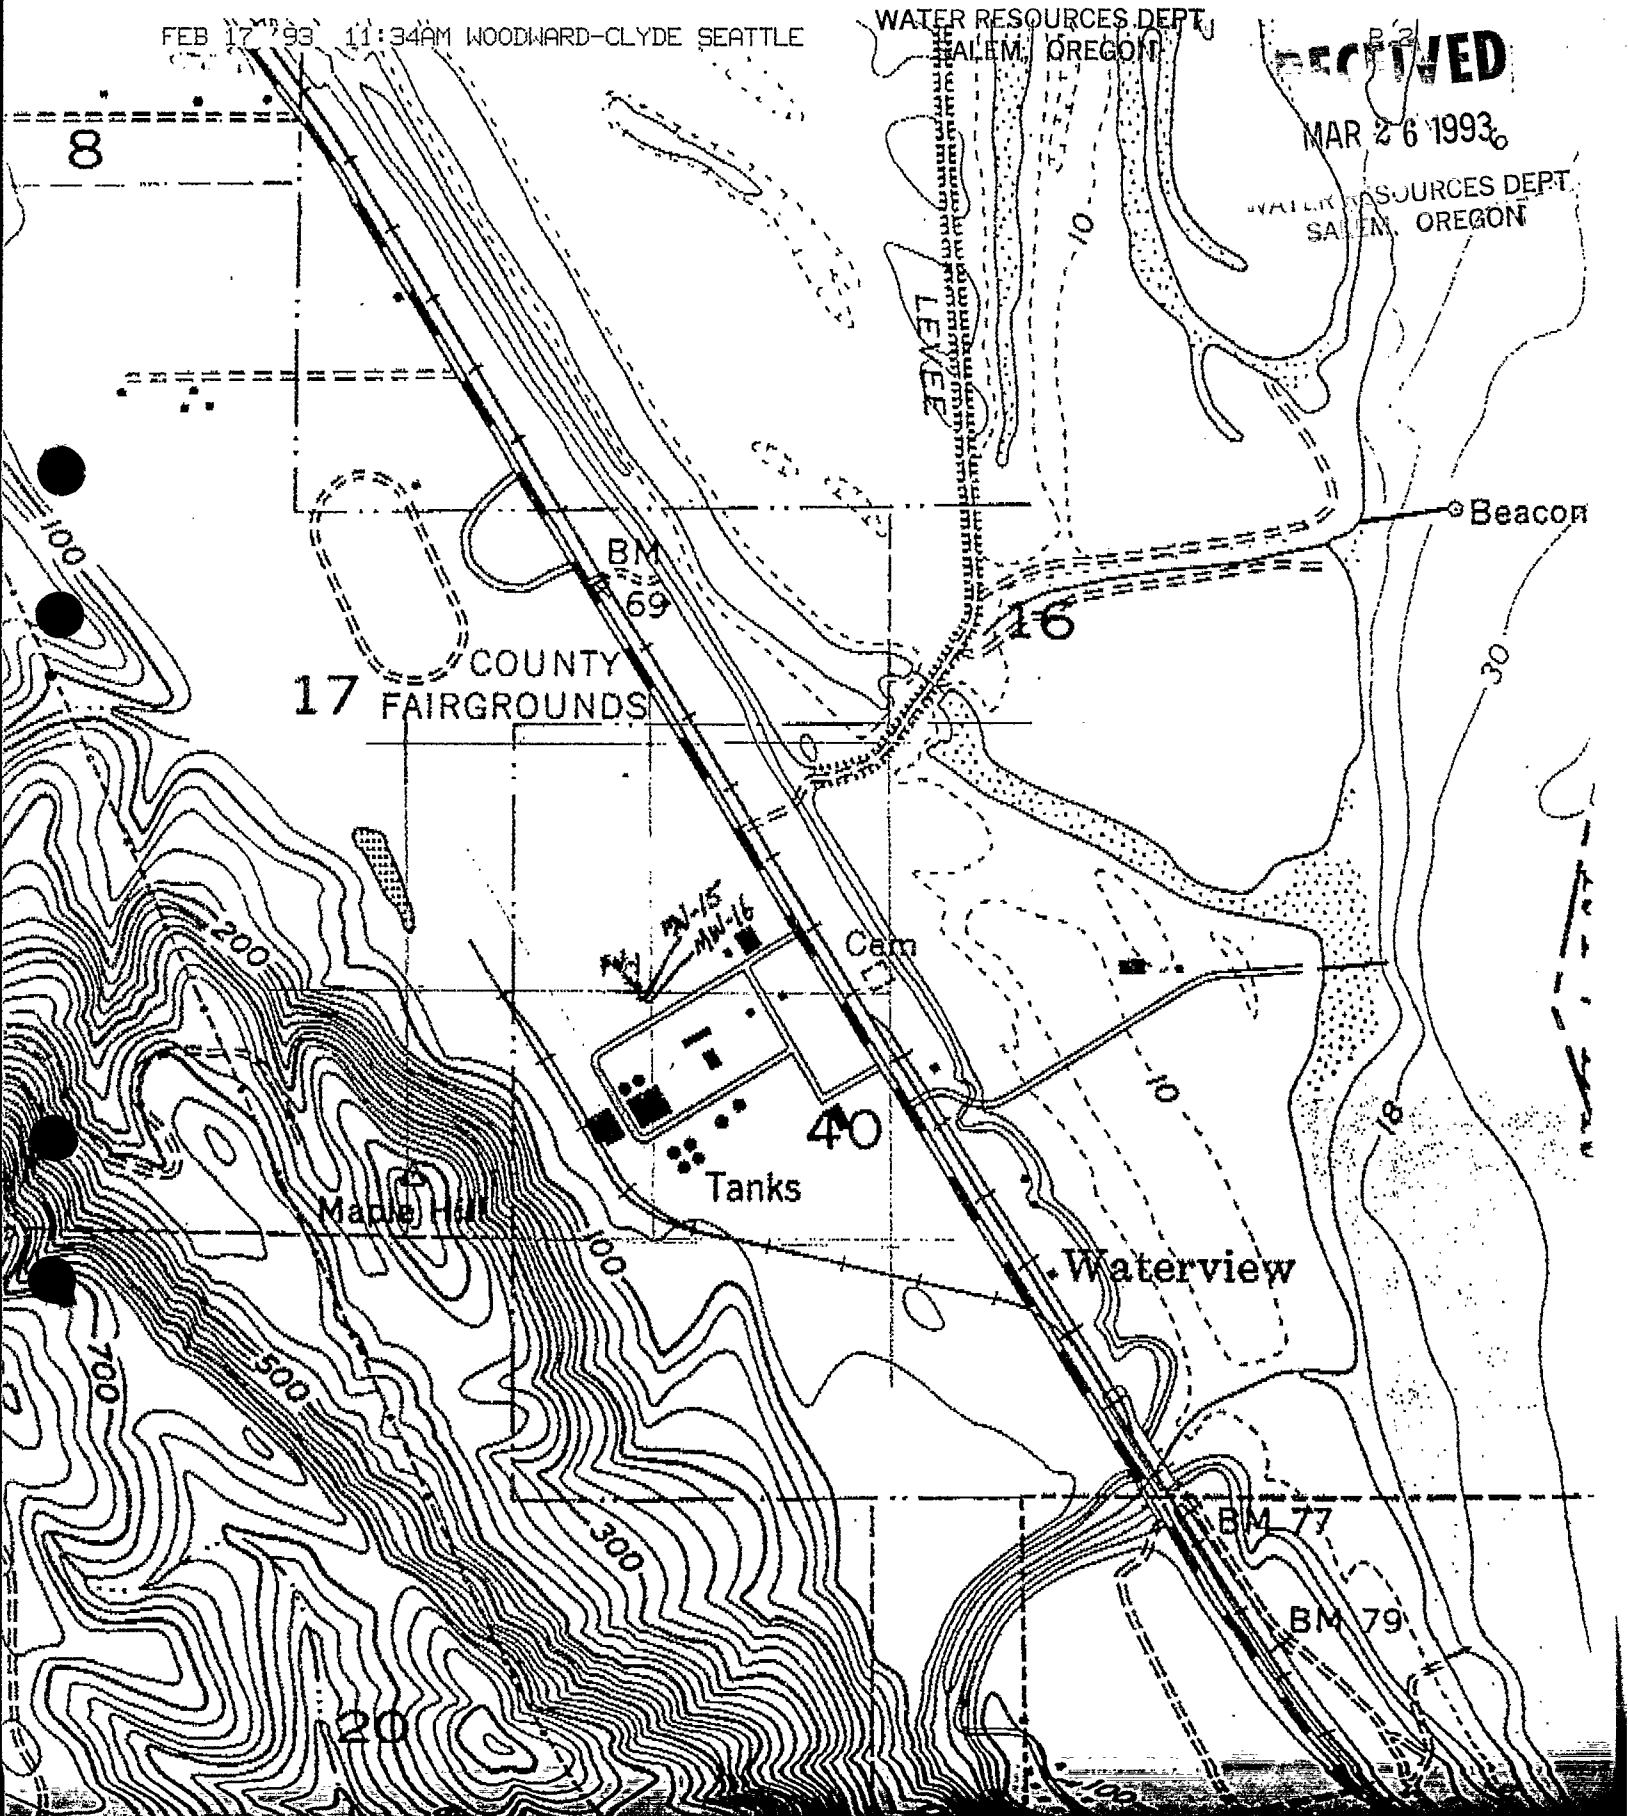



Oregon Water Resources Department
725 Summer Street NE, Suite A
Salem Oregon 97301
(503) 986-0900
www.oregon.gov/owrd

Application for Well ID Number

Do not complete if the well already has a Well Identification Number.

RECEIVED

AUG 15 2023

I. OWNER INFORMATION

OWRD

Current Owner Name (please print): Dyno Nobel, Inc.

Mailing Address: 63149 Columbia River Hwy.

City, State, Zip: Deer Island, Oregon 97054

Mail Well ID to: ☒ SAME AS ABOVE ☒ In Care Of (C/O)

Name & Address: Fran Erickson 63149 Columbia River Hwy

City, State, Zip: Deer Island, Oregon 97054

II. WELL LOCATION INFORMATION (Please fill out as completely as possible)

Township: 5 (North / South) Range: 1 (East / West) Section: 17 SW 1/4 of the SE 1/4

Tax Lot (usually last 3-5 numbers of Tax Map #): 303 County Columbia

GPS Coordinates: 45.91307873 -122.8298691

Street Address of Well, City: 63201 Columbia River Highway, Deer Island

If the property had a different street address in the past: Site Specific Well ID = PW-1

III. GENERAL WELL INFORMATION (Please fill out as completely as possible, AND attach copy of Well Report, if available)

Use of Well (domestic, irrigation, commercial, industrial, monitoring): Industrial

Date Well Constructed (or property built): 2/26/1993 Total Well Depth: 90.0 ft Casing Diameter: 6 inches

Owner at time the well was constructed (if known): Chevron Chemical Co. Well Report # (if known): COLU 618

Other Information: NA

SUBMITTED BY (please print): Fran Erickson

PHONE: 503-366-8902

EMAIL &/or FAX: Fran.Erickson@Am.DynoNobel.com

To send the completed application, you may MAIL it to: Oregon Water Resources Dept. 725 Summer St NE, Suite A, Salem, Oregon 97301.
Or EMAIL the completed PDF form to: Ladeena.K.Ashley@water.oregon.gov, or FAX it to: (503) 986-0902.

For Official Use Only by the Oregon Water Resources Department:

Received Date:

8-15-2023

Well Report Number:

COLU 618

Well Identification #:

L-152825