

STATE OF OREGON
MONITORING WELL REPORT
(as required by ORS 537.765 & OAR 690-240-095)

RECEIVED
MAY 17 1993

5N/1W/17dc
Start Card # 38293

(1) OWNER/PROJECT:

Name Chevron Chemical Co.
Address 63149 Columbia River Hwy.
City St. Helens State OR Zip 97051

(2) TYPE OF WORK:


- ☒ New construction ☐ Repair ☐ Recondition
☐ Conversion ☐ Deepening ☐ Abandonment

(3) DRILLING METHOD

- ☐ Rotary Air ☐ Rotary Mud ☐ Cable
☐ Hollow Stem Auger ☒ Other Reversal Percussion Hammer A.R.

(4) BORE HOLE CONSTRUCTION

Special Standards Yes No ☐ ☐ Depth of completed well 93' ft.

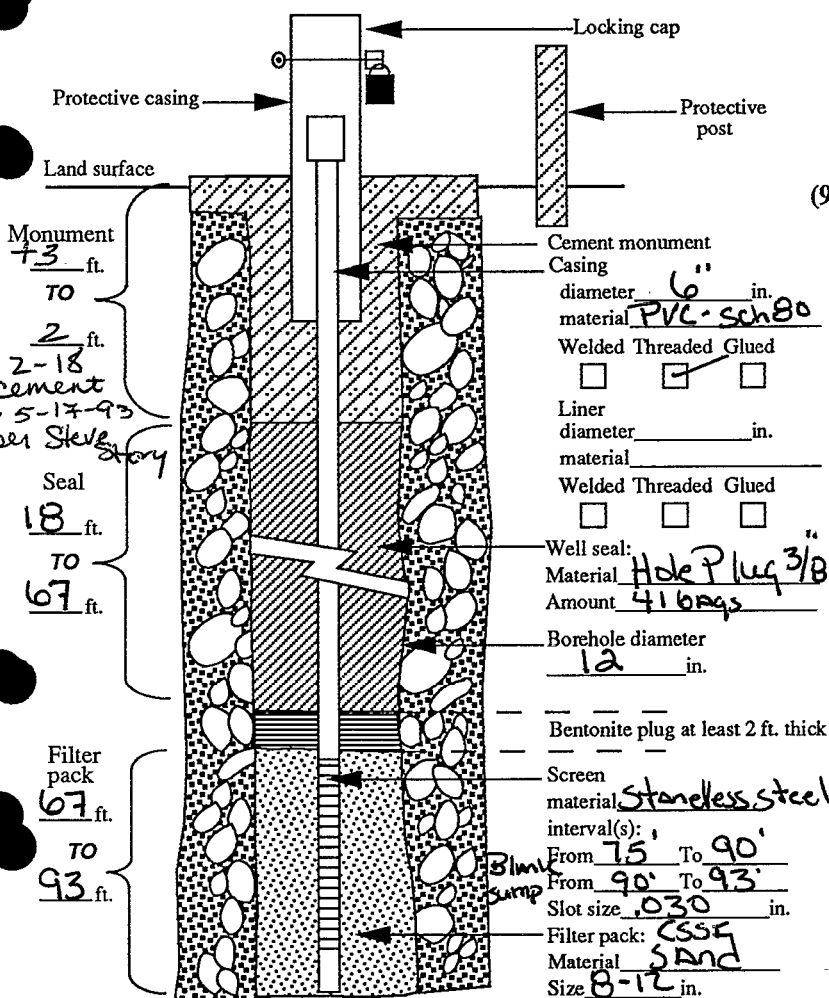

(6) LOCATION OF WELL By legal description

Well Location: County Columbia
Township 5 (N or S) Range 1 (E or W) Section 17
1. SE 1/4 of SE 1/4 of above section.
2. Street address of well location 63149 Columbia River Hwy
3. Tax lot number of well location 2-0851700000203
4. ATTACH MAP WITH LOCATION IDENTIFIED.

(7) STATIC WATER LEVEL:

68 Ft. below land surface. Date 4-7-93
Artesian Pressure lb/sq. in. Date

(8) WATER BEARING ZONES:

From	To	Est. Flow Rate	SWL

(9) WELL LOG:

Ground elevation

Material	From	To	SWL
Fine sand with some silt to trace med gravel brown damp			
Silty coarse gravelly coarse sand little cobbles gray-brown	20'	60'	
Silty coarse sandy med to coarse gravel with some cobbles gray brown damp	60'	80'	
Sandy silty gravel very wet flowing water	80'	93'	

Date started 4-7-93 Completed 4-7-93

(5) WELL TEST:

- ☐ Pump ☐ Bailer ☐ Air ☐ Flowing Artesian
Permeability Yield GPM
Conductivity PH
Temperature of water 12.6 °C Depth artesian flow found ft.
Was water analysis done? ☐ Yes ☐ No

By whom?
Depth of strata to be analyzed. From ft. to ft.
Remarks:

Name of supervising Geologist/Engineer Galen Davis

(unbonded) Monitor Well Constructor Certification:

I certify that the work I performed on the construction, alteration, or abandonment of this well is in compliance with Oregon well construction standards. Materials used and information reported above are true to the best knowledge and belief.

Signed Steve Story MWC Number 10205
Date 4-19-93

(bonded) Monitor Well Constructor Certification:


I accept responsibility for the construction, alteration, or abandonment work performed on this well during the construction dates reported above. All work performed during this time is in compliance with Oregon well construction standards. This report is true to the best of my knowledge and belief.

Signed Steve Story MWC Number 10093
Date 5/3/93

RECEIVED

MAY 10 1993

WATER RESOURCES DEPT.
SALEM, OREGON

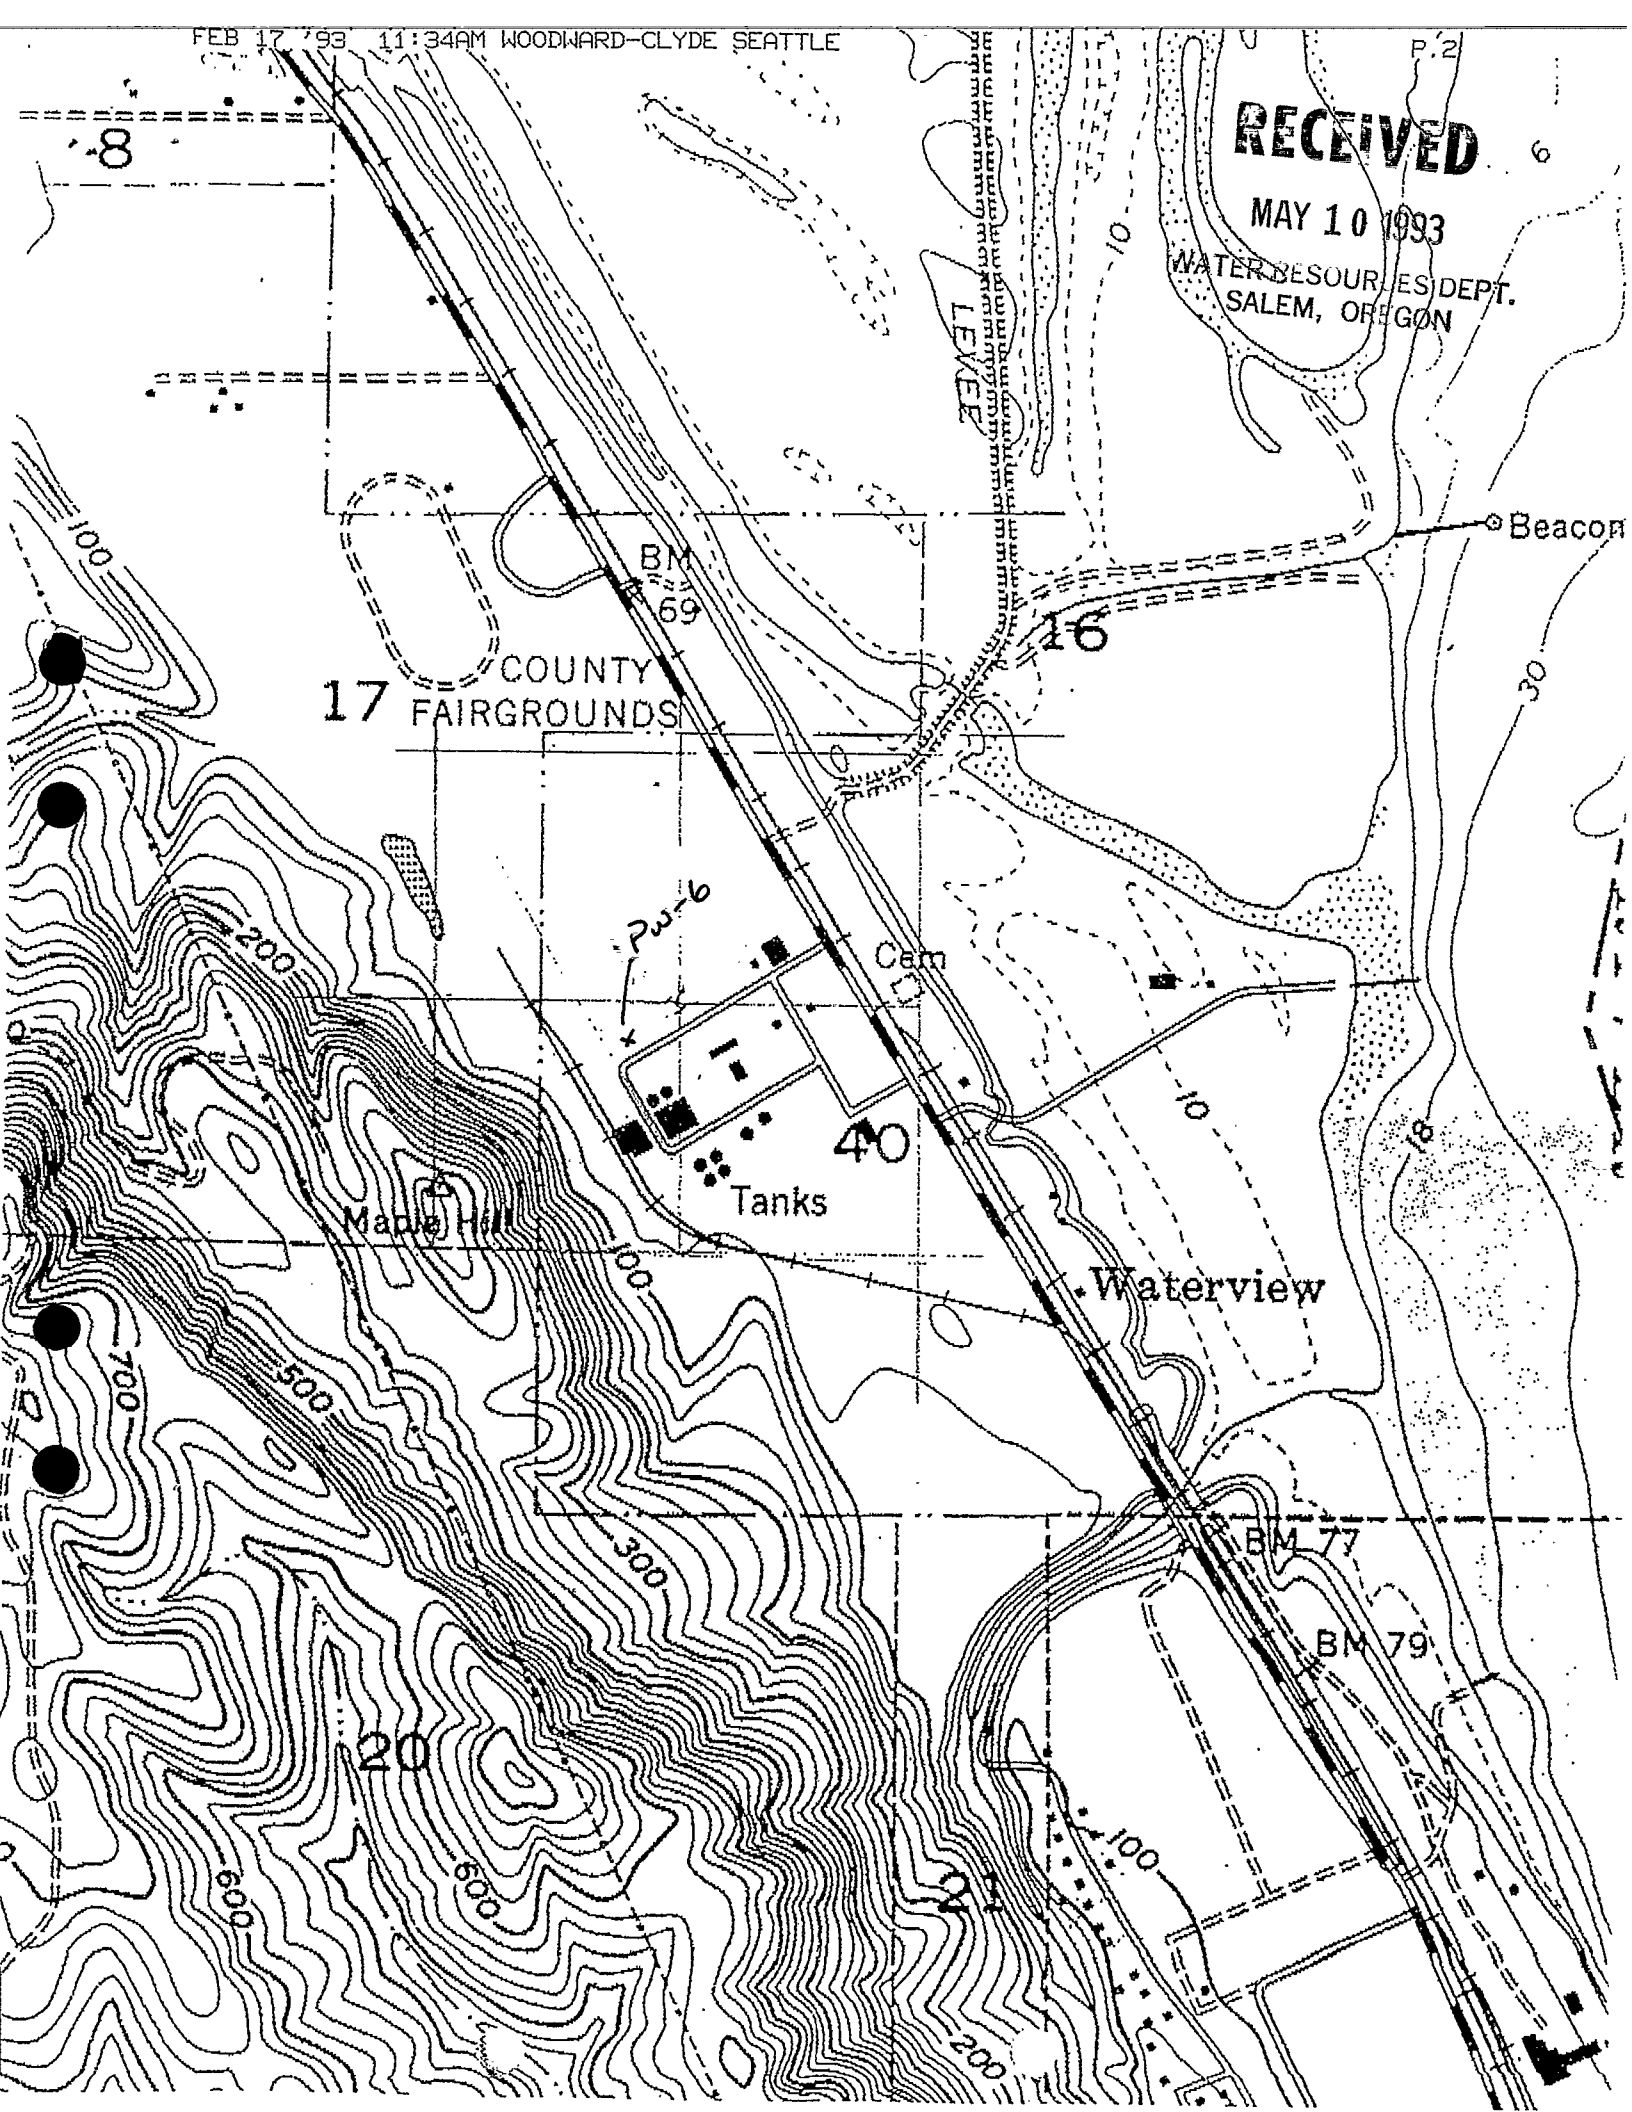



Oregon Water Resources Department
725 Summer Street NE, Suite A
Salem Oregon 97301
(503) 986-0900
www.oregon.gov/owrd

Application for Well ID Number

Do not complete if the well already has a Well Identification Number.

RECEIVED

AUG 15 2023

I. OWNER INFORMATION

OWRD

Current Owner Name (please print): Dyno Nobel, Inc.

Mailing Address: 63149 Columbia River Hwy.

City, State, Zip: Deer Island, Oregon 97054

Mail Well ID to: ☒ SAME AS ABOVE ☒ In Care Of (C/O)

Name & Address: Fran Erickson 63149 Columbia River Hwy

City, State, Zip: Deer Island, Oregon 97054

II. WELL LOCATION INFORMATION (Please fill out as completely as possible)

Township: 5 (North / South) Range: 1 (East / West) Section: 17 SW 1/4 of the SE 1/4

Tax Lot (usually last 3-5 numbers of Tax Map #): 203 County Columbia

GPS Coordinates: 45.91272011 -122.8306482

Street Address of Well, City: 63201 Columbia River Highway, Deer Island

If the property had a different street address in the past: Site Specific Well ID = PW-6

III. GENERAL WELL INFORMATION (Please fill out as completely as possible, AND attach copy of Well Report, if available)

Use of Well (domestic, irrigation, commercial, industrial, monitoring): Industrial

Date Well Constructed (or property built): 4/7/1993 Total Well Depth: 93.0 Casing Diameter: 6 Inches

Owner at time the well was constructed (if known): Chevron Chemical Co. Well Report # (if known): COLU 662

Other Information: NA

SUBMITTED BY (please print): Fran Erickson

PHONE: 503-366-8902

EMAIL &/or FAX: Fran.Erickson@Am.DynoNobel.com

To send the completed application, you may MAIL it to: Oregon Water Resources Dept. 725 Summer St NE, Suite A, Salem, Oregon 97301.
Or EMAIL the completed PDF form to: Ladeena.K.Ashley@water.oregon.gov, or FAX it to: (503) 986-0902.

For Official Use Only by the Oregon Water Resources Department:

Received Date:

8-15-2023

Well Report Number:

COLU 662

Well Identification #:

L-152830