

STATE OF OREGON
MONITORING WELL REPORT
(as required by ORS 537.765 & OAR 690-240-095)

WATER RESOURCES DEPT.

Start Card # 138290

(1) OWNER/PROJECT:

Name Chevron Chemical Co.
Address 63149 Columbia River Hwy.
City St. Helens State OR Zip 97051

(2) TYPE OF WORK:


☒ New construction ☐ Repair ☐ Recondition
☐ Conversion ☐ Deepening ☐ Abandonment

(3) DRILLING METHOD

☐ Rotary Air ☐ Rotary Mud ☐ Cable ☒ Other Reverse Percussion Hammer Air
☐ Hollow Stem Auger

(4) BORE HOLE CONSTRUCTION

Special Standards Yes No ☐ ☐ Depth of completed well 93' ft.

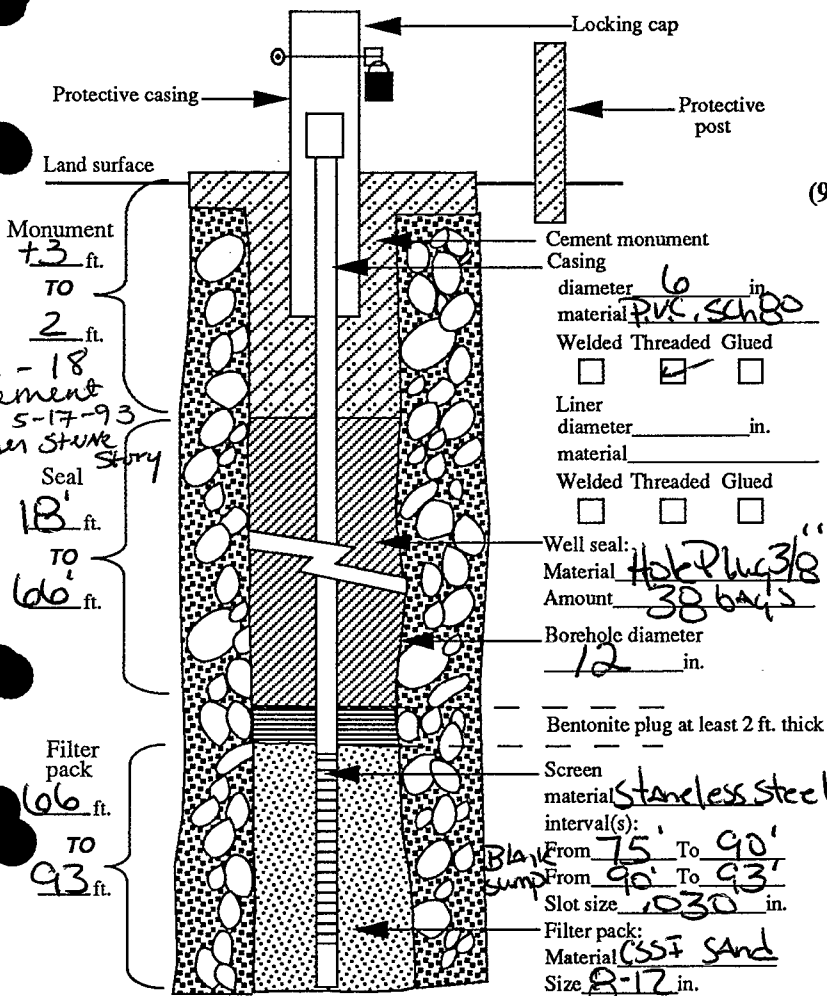

(6) LOCATION OF WELL By legal description

Well Location: County Columbia
Township 5 (N or S) Range 1 (E or W) Section 17
1. SE 1/4 of SE 1/4 of above section.
2. Street address of well location 63149 Columbia River Hwy.
3. Tax lot number of well location 2-0851700000203
4. ATTACH MAP WITH LOCATION IDENTIFIED.

(7) STATIC WATER LEVEL:

68 Ft. below land surface. Date 4-12-93
Artesian Pressure lb/sq. in. Date

(8) WATER BEARING ZONES:

From	To	Est. Flow Rate	SWL

(9) WELL LOG:

Ground elevation

Material	From	To	SWL
Silty Fine sand			
med. to coarse gravel			
Wet. brown	0	20'	
Silty sandy med.			
Gravel, moist gray			
brown	20'	49'	
Silty med. to coarse			
Sandy med gravel			
moist gray brown	49'	60'	
Med to fine silty			
sand, flowing water			
Reddish brown	60'	90'	
Silty sand with			
some gravel flowing	90'	93'	
water			

Date started 4-12-93 Completed 4-12-93

(5) WELL TEST:

☐ Pump ☐ Bailer ☐ Air ☐ Flowing Artesian

Permeability Yield GPM

Conductivity PH

Temperature of water 12.8 °F Depth artesian flow found ft.

Was water analysis done? ☐ Yes ☐ No

By whom?

Depth of strata to be analyzed. From ft. to ft.

Remarks:

Name of supervising Geologist/Engineer Galen Davis

(unbonded) Monitor Well Constructor Certification:

I certify that the work I performed on the construction, alteration, or abandonment of this well is in compliance with Oregon well construction standards. Materials used and information reported above are true to the best knowledge and belief.

Signed [Signature] MWC Number 10205 Date 4-19-93

(bonded) Monitor Well Constructor Certification:


I accept responsibility for the construction, alteration, or abandonment work performed on this well during the construction dates reported above. All work performed during this time is in compliance with Oregon well construction standards. This report is true to the best of my knowledge and belief.

Signed [Signature] MWC Number 10093 Date 5/3/93

RECEIVED

MAY 10 1993

WATER RESOURCES DEPT.
SALEM, OREGON

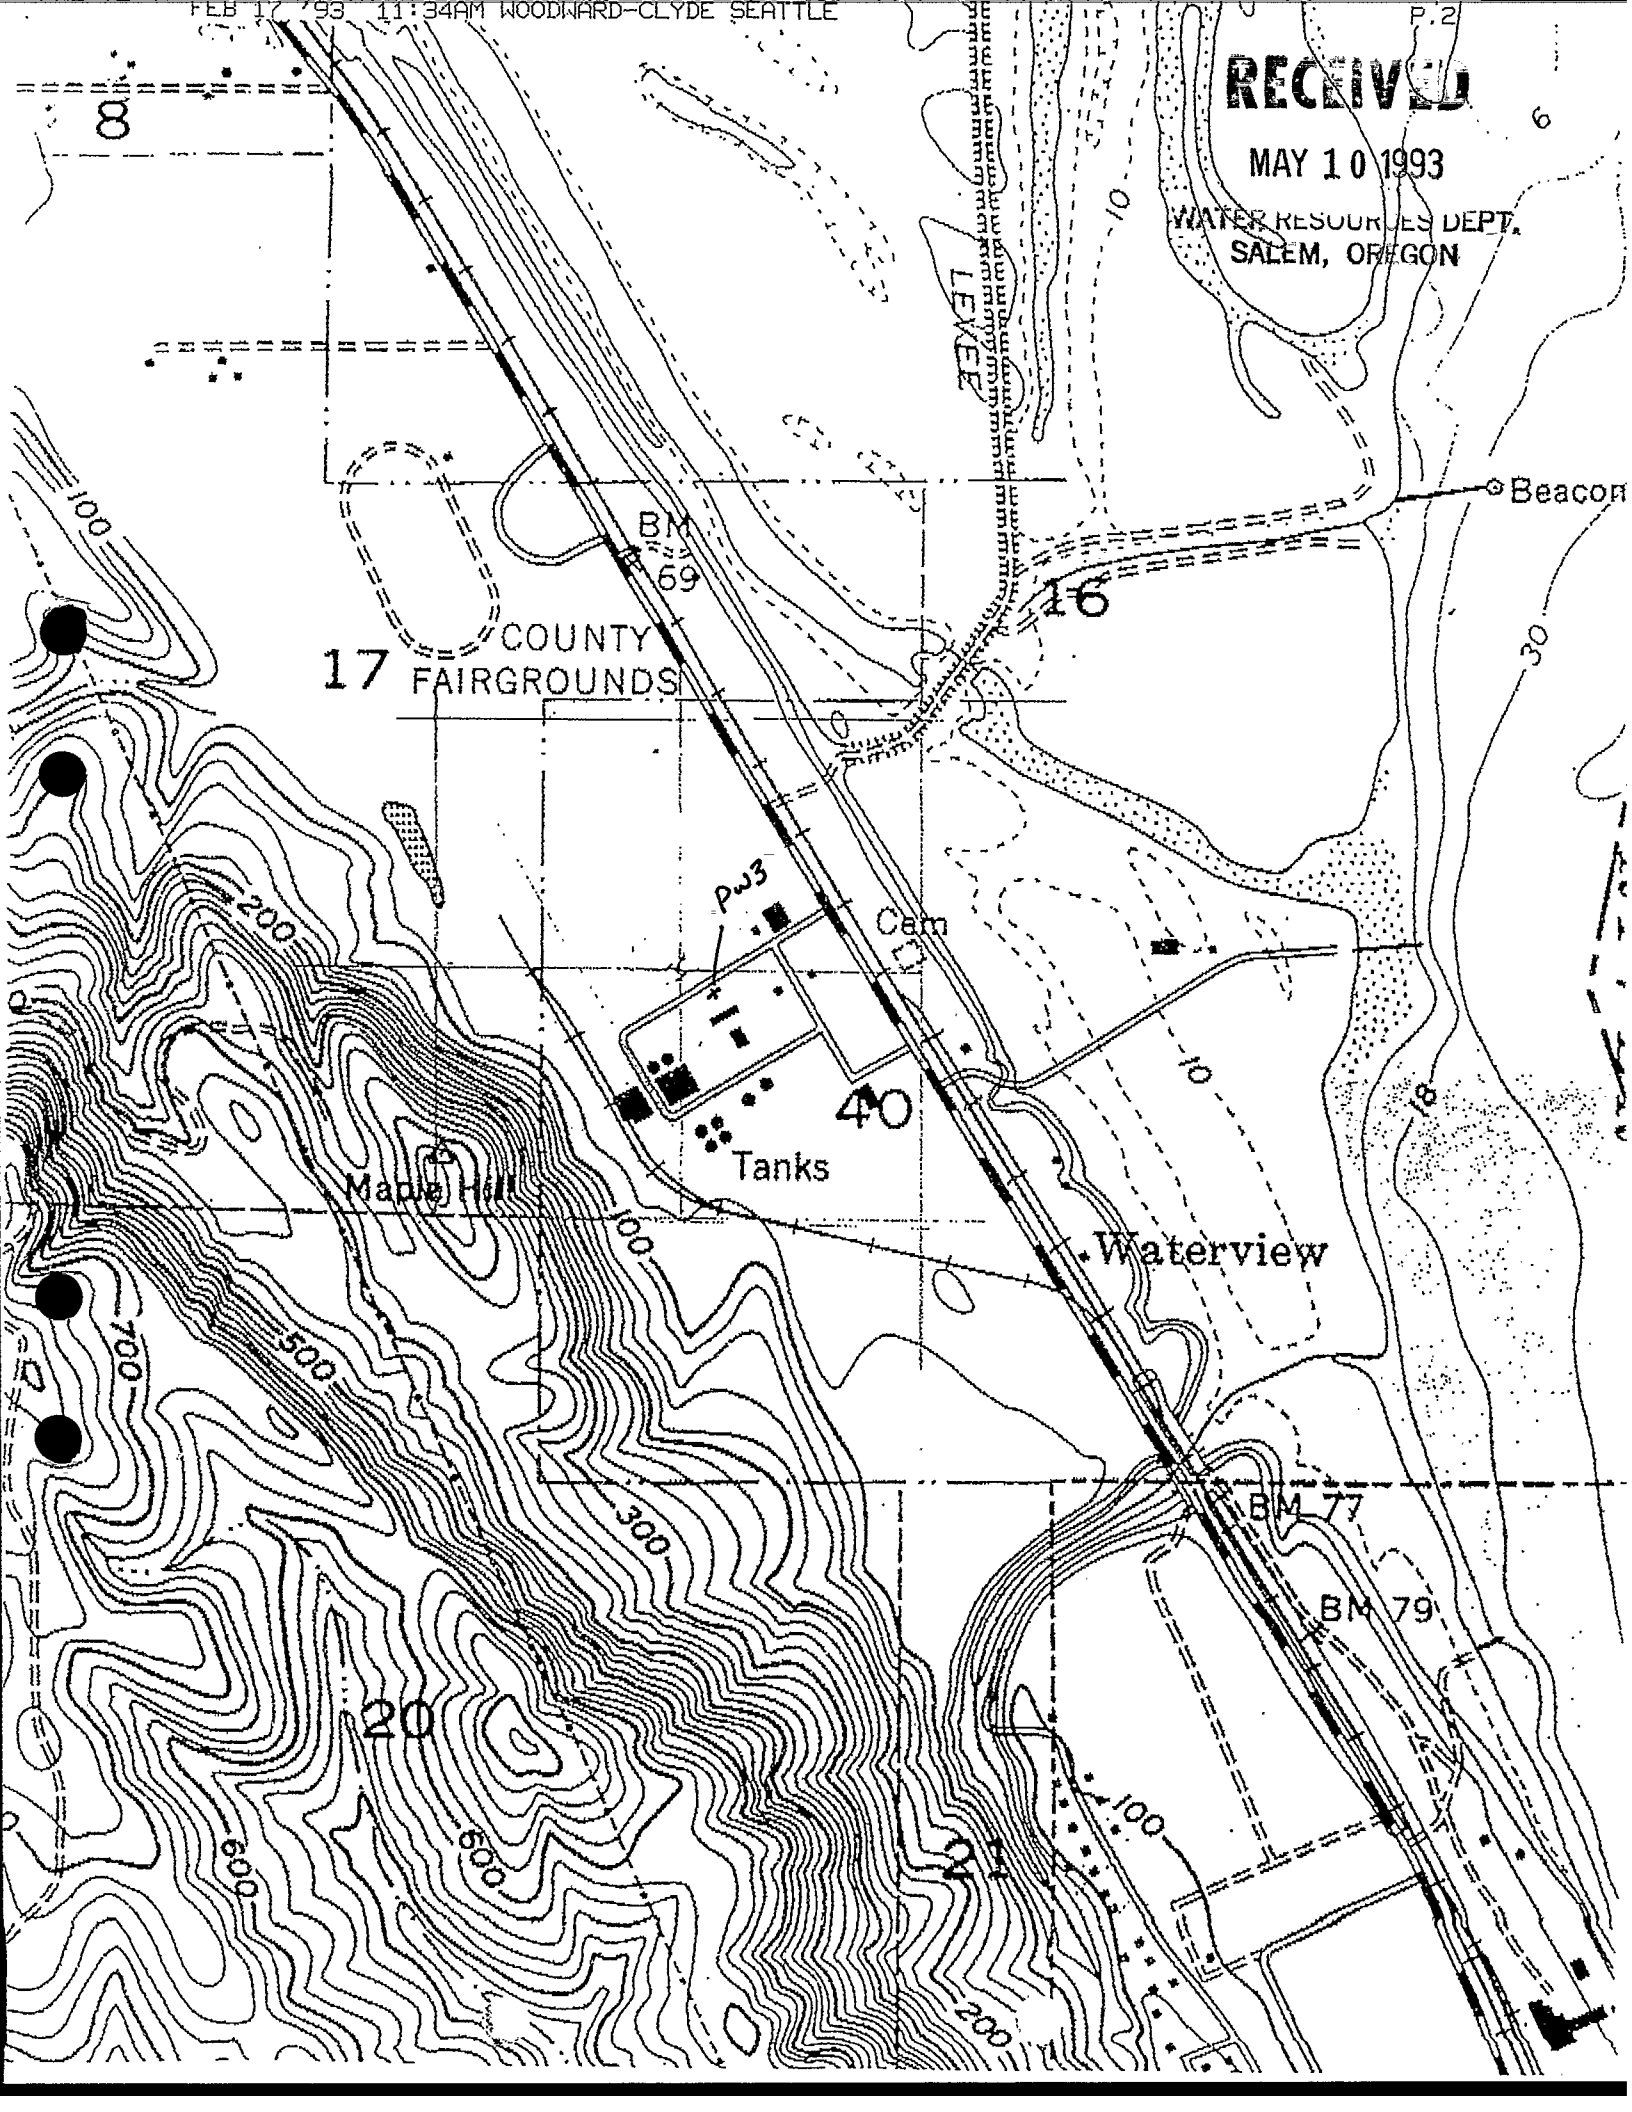



Oregon Water Resources Department
725 Summer Street NE, Suite A
Salem Oregon 97301
(503) 986-0900
www.oregon.gov/owrd

Application for Well ID Number

Do not complete if the well already has a Well Identification Number.

RECEIVED

AUG 15 2023

OWRD

I. OWNER INFORMATION

Current Owner Name (please print): Dyno Nobel, Inc.

Mailing Address: 63149 Columbia River Hwy.

City, State, Zip: Deer Island, Oregon 97054

Mail Well ID to: ☒ SAME AS ABOVE ☒ In Care Of (C/O)

Name & Address: Fran Erickson 63149 Columbia River Hwy

City, State, Zip: Deer Island, Oregon 97054

II. WELL LOCATION INFORMATION (Please fill out as completely as possible)

Township: 5 (North / South) Range: 1 (East / West) Section: 17 SE 1/4 of the SE 1/4

Tax Lot (usually last 3-5 numbers of Tax Map #): 203 County Columbia

GPS Coordinates: 45.9128205 -122.8290685

Street Address of Well, City: 63149 Columbia River Hwy, Deer Island

If the property had a different street address in the past: Site Specific Well ID = PW-3

III. GENERAL WELL INFORMATION (Please fill out as completely as possible, AND attach copy of Well Report, if available)

Use of Well (domestic, irrigation, commercial, industrial, monitoring): Industrial

Date Well Constructed (or property built): 4/12/1993 Total Well Depth: 93.0 ft Casing Diameter: 6 Inches

Owner at time the well was constructed (if known): Chevron Chemical Co. Well Report # (if known): COLU 663

Other Information: NA

SUBMITTED BY (please print): Fran Erickson

PHONE: 503-366-8902

EMAIL &/or FAX: Fran.Erickson@Am.DynoNobel.com

To send the completed application, you may MAIL it to: Oregon Water Resources Dept. 725 Summer St NE, Suite A, Salem, Oregon 97301.
Or EMAIL the completed PDF form to: Ladeena.K.Ashley@water.oregon.gov, or FAX it to: (503) 986-0902.

For Official Use Only by the Oregon Water Resources Department:

Received Date:

8-15-2023

Well Report Number:

COLU 663

Well Identification #:

L-152827